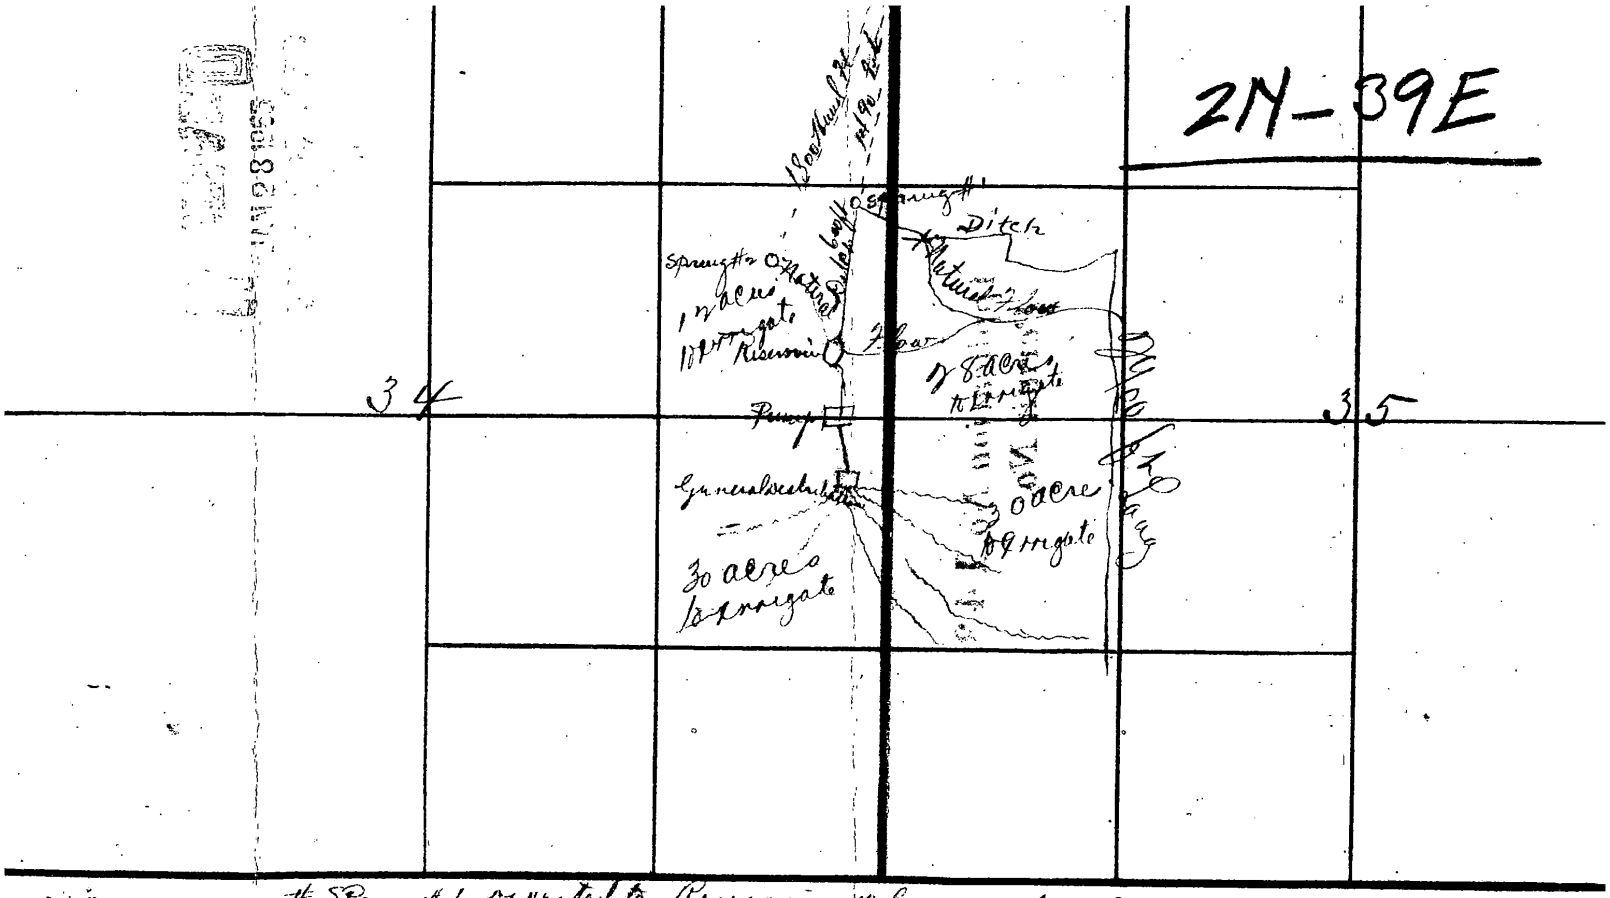

Spring #1 diverted to Reservoir when needed for storage
Spring #2 natural flow to reservoir
Main ditch to Reservoir to pump 370 ft long

Application
Permit No