

SECTION

RECEIVED

SEP 14 1982

RECEIVED

JUL 21 1981


WATER RESOURCES DEPT.

SALEM, OREGON

TOWNSHIP 39S., RANGE 19E., W. M.

WATER RESOURCES DEPT.  
SALEM, OREGON

North

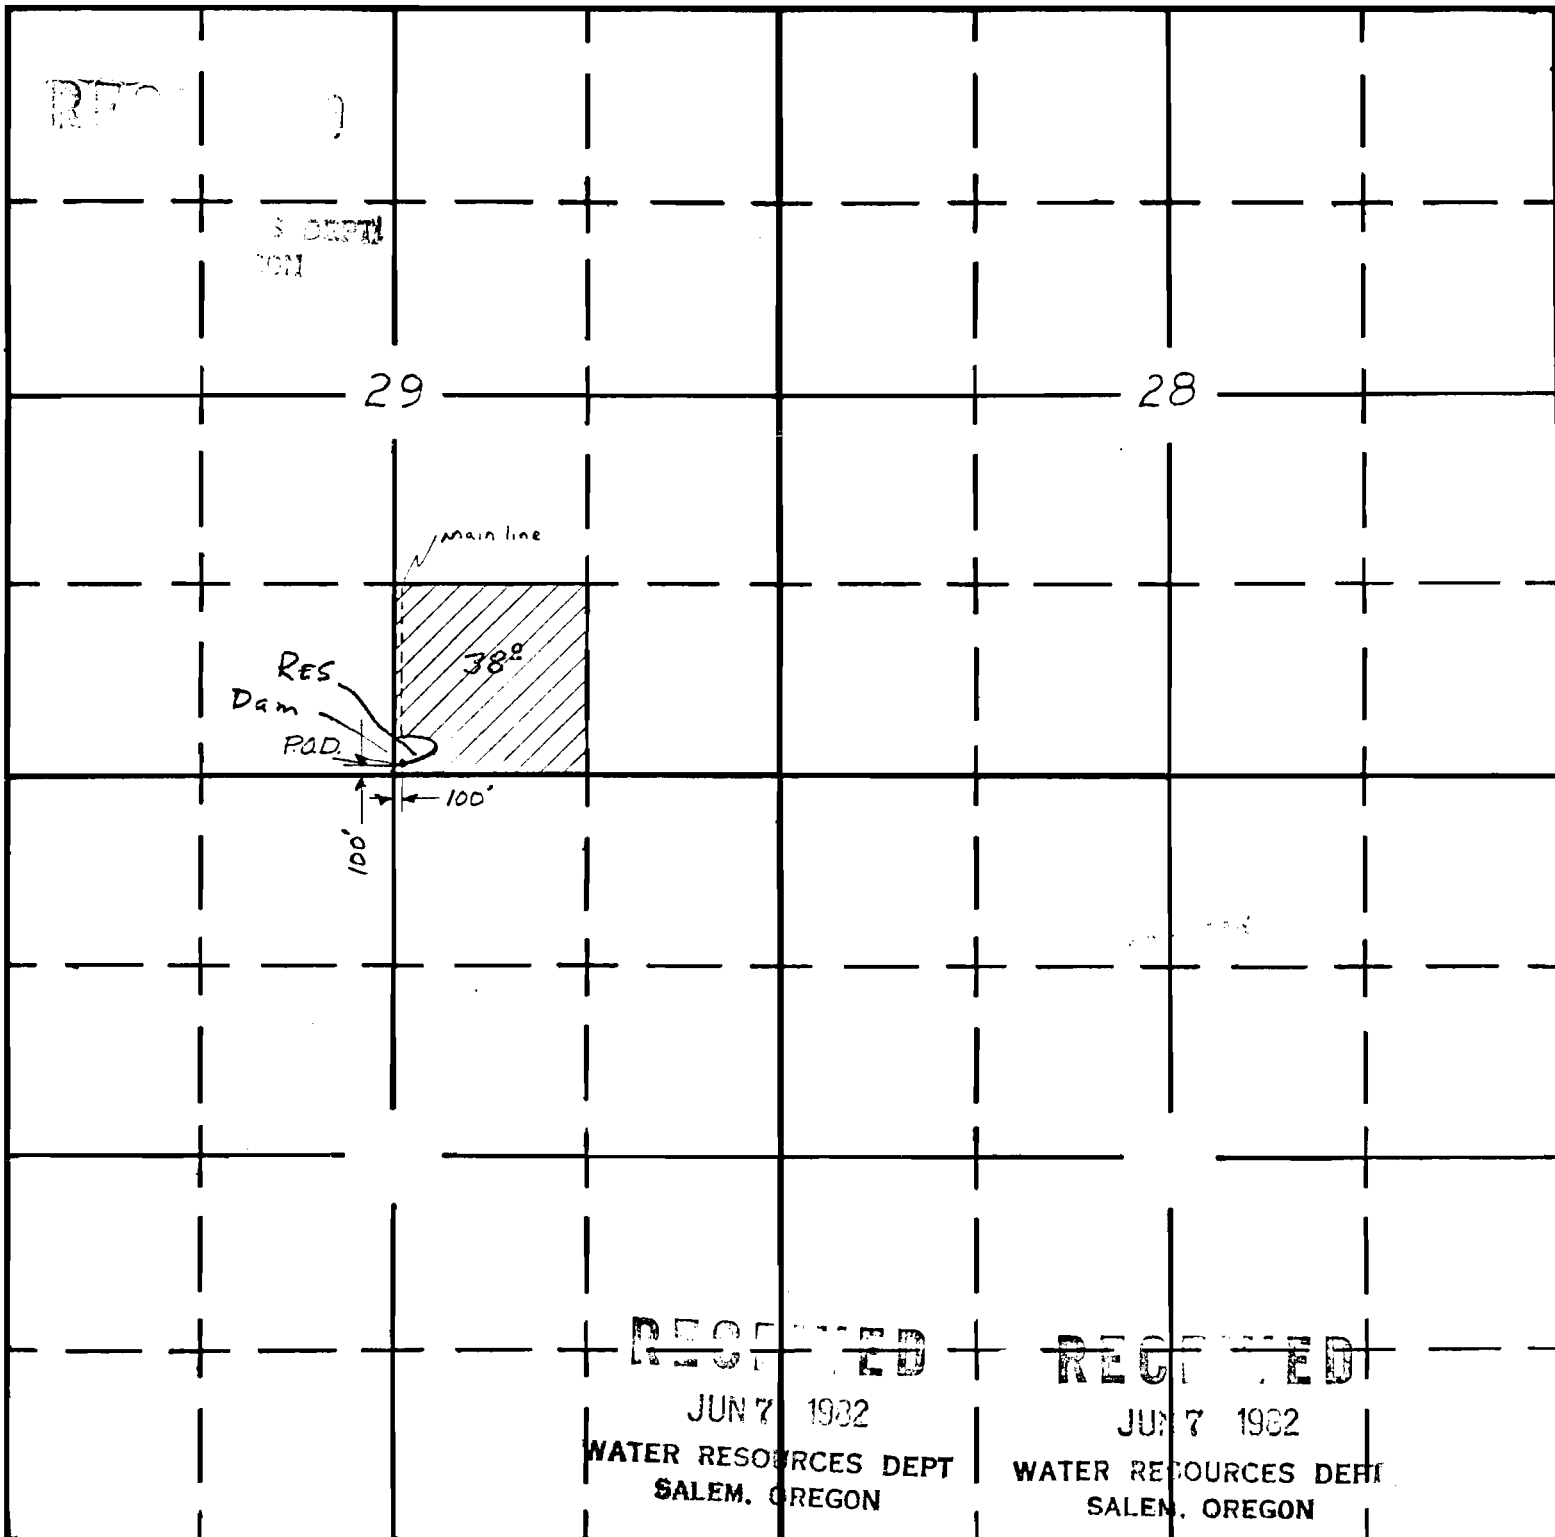

Scale - 4" = 1 mi

South

All information on this map furnished by applicant

*Kevin Smith* *Kayle W. Smith*  
Applicant

RECEIVED

NOV 25 1980

WATER RESOURCES DEPT.

Application No. 61018 & R-6359  
Permit No. 47021 R 850