

RECEIVED

AUG 25 1982  
WATER RESOURCES DEPT.  
SALEM, OREGON

For Department Office Use Only

SE 1/4 SW 1/4 SECTION 20 T8S R10W WM

8 10 20 CD


LINCOLN COUNTY

1" = 100'

CODE - 461

See Map 8 10 20

Application No. 63952  
Permit No. 47053

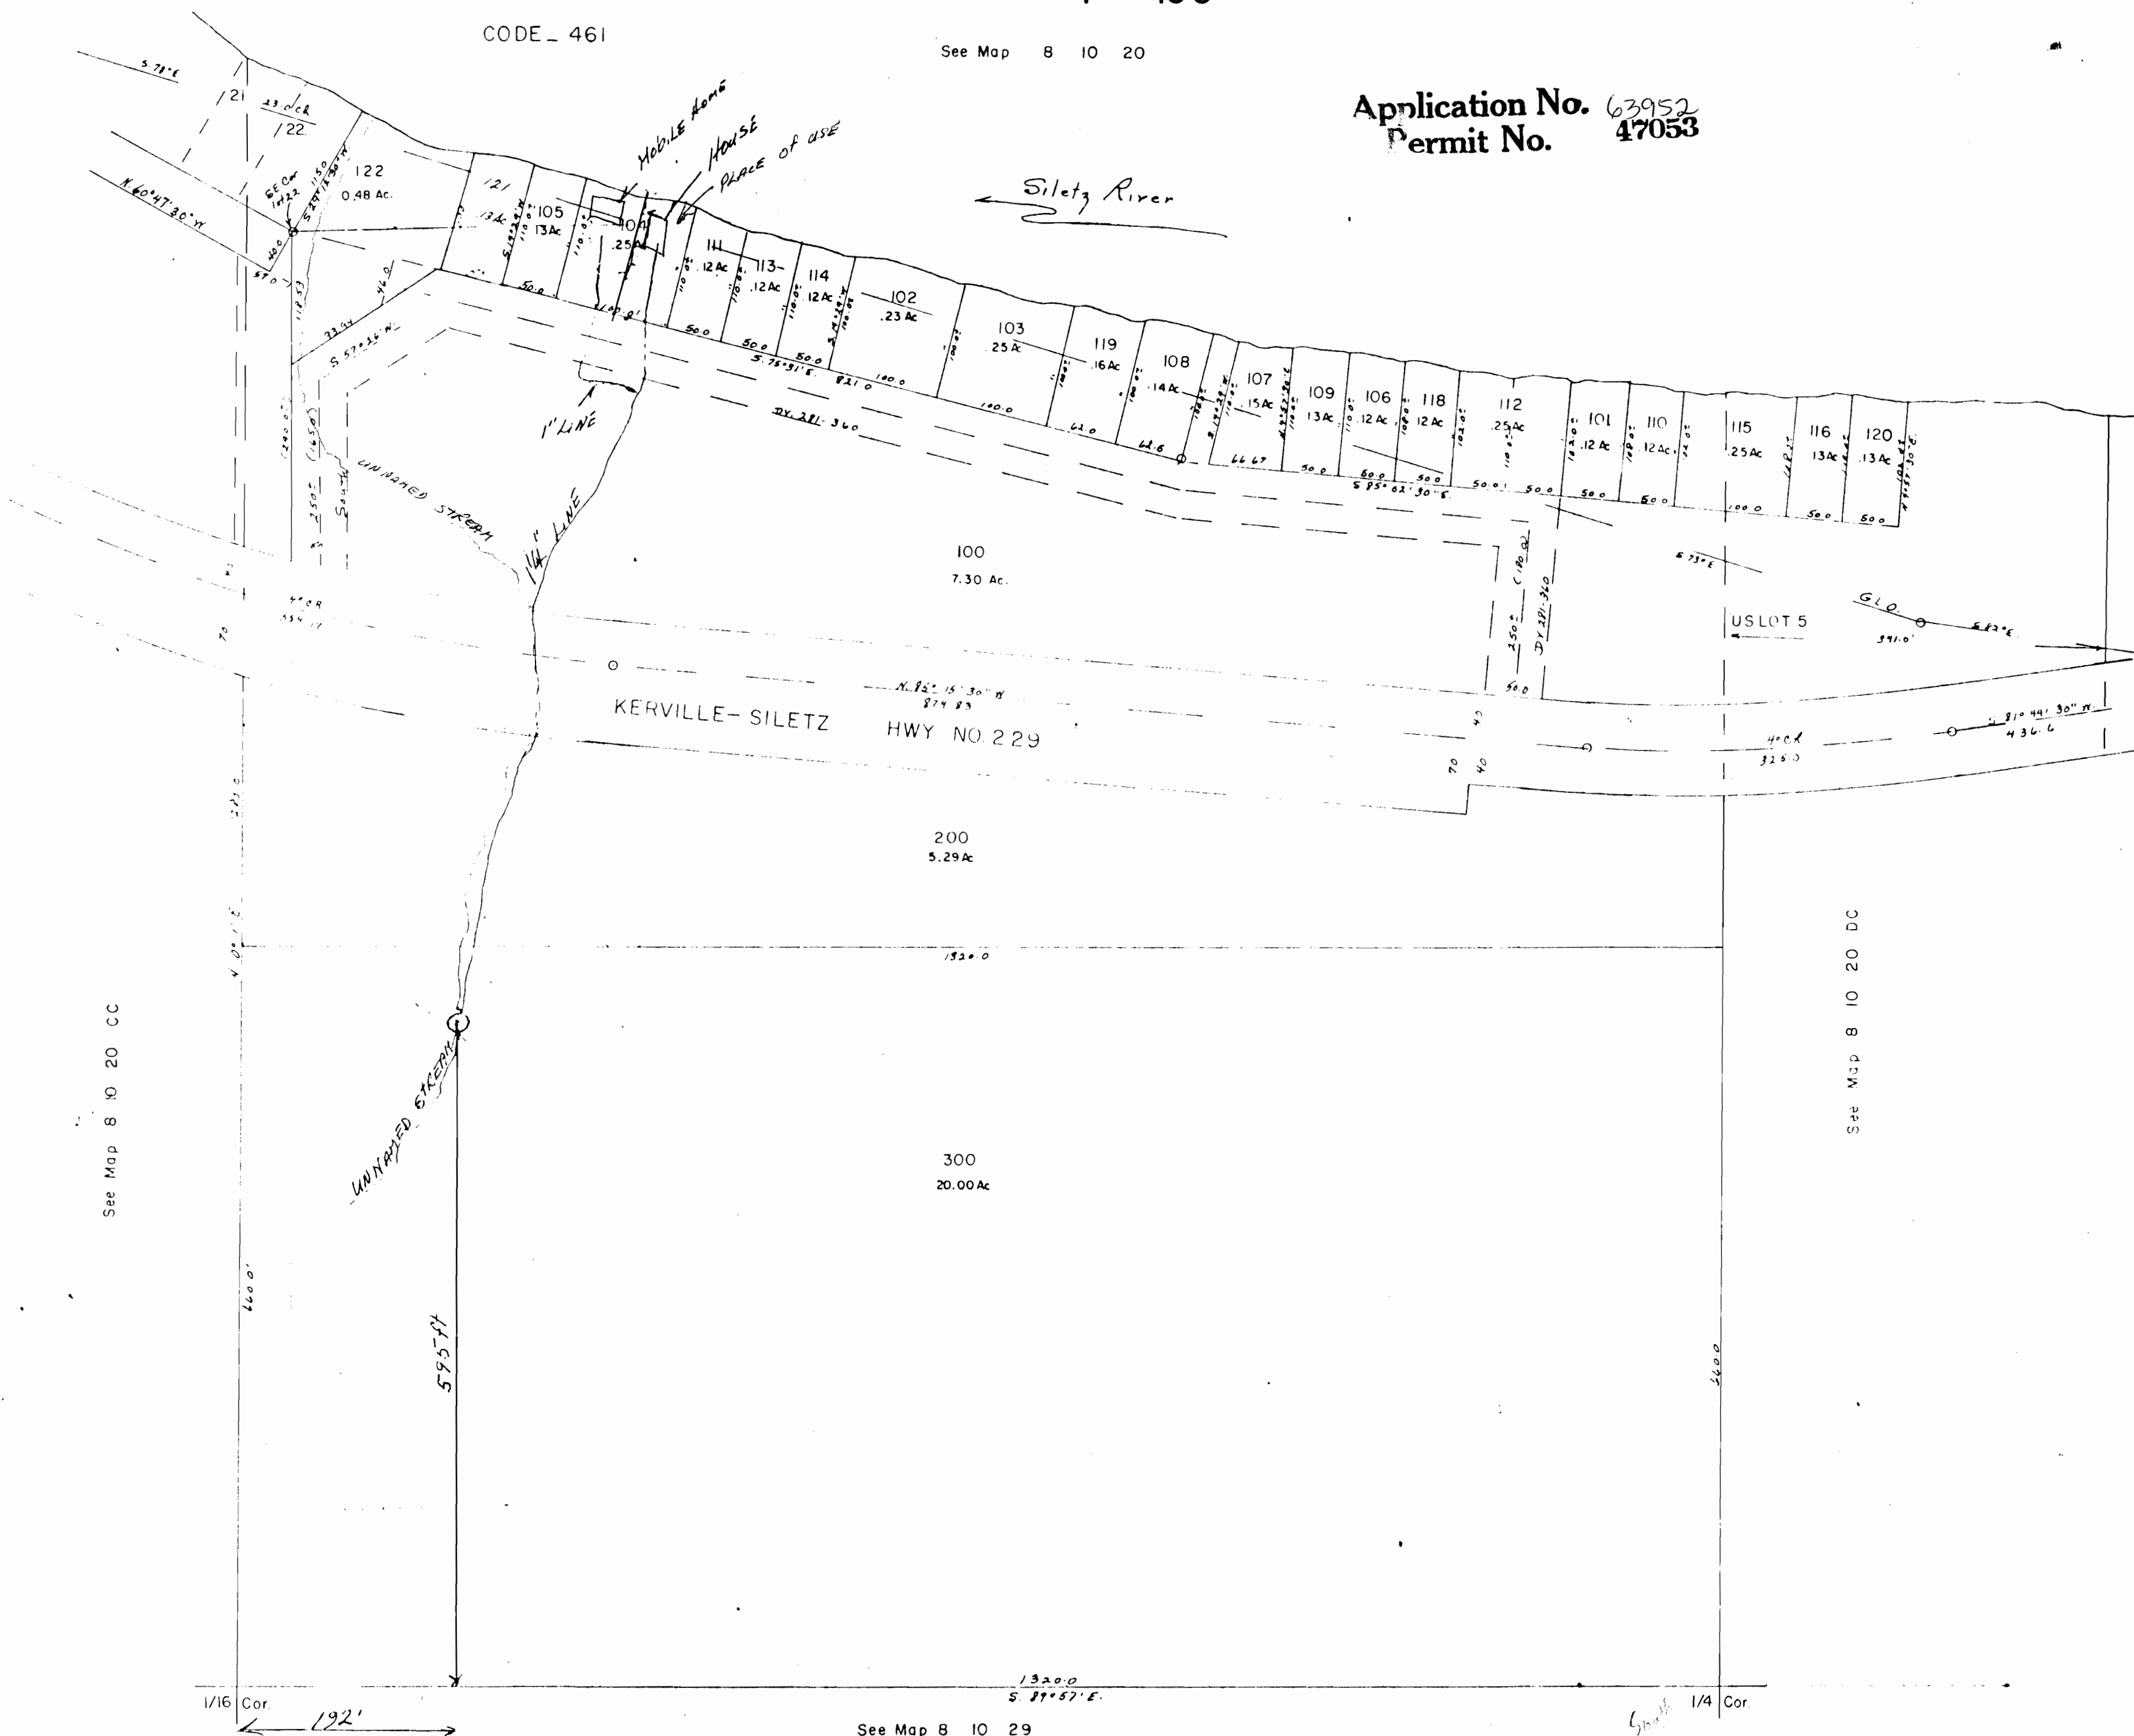

See Map 8 10 20 CC

See Map 8 10 20 DC

See Map 8 10 29

8 10 20 CD