


T IN R 15 E

REA POWER LINE ON SECTION LINE

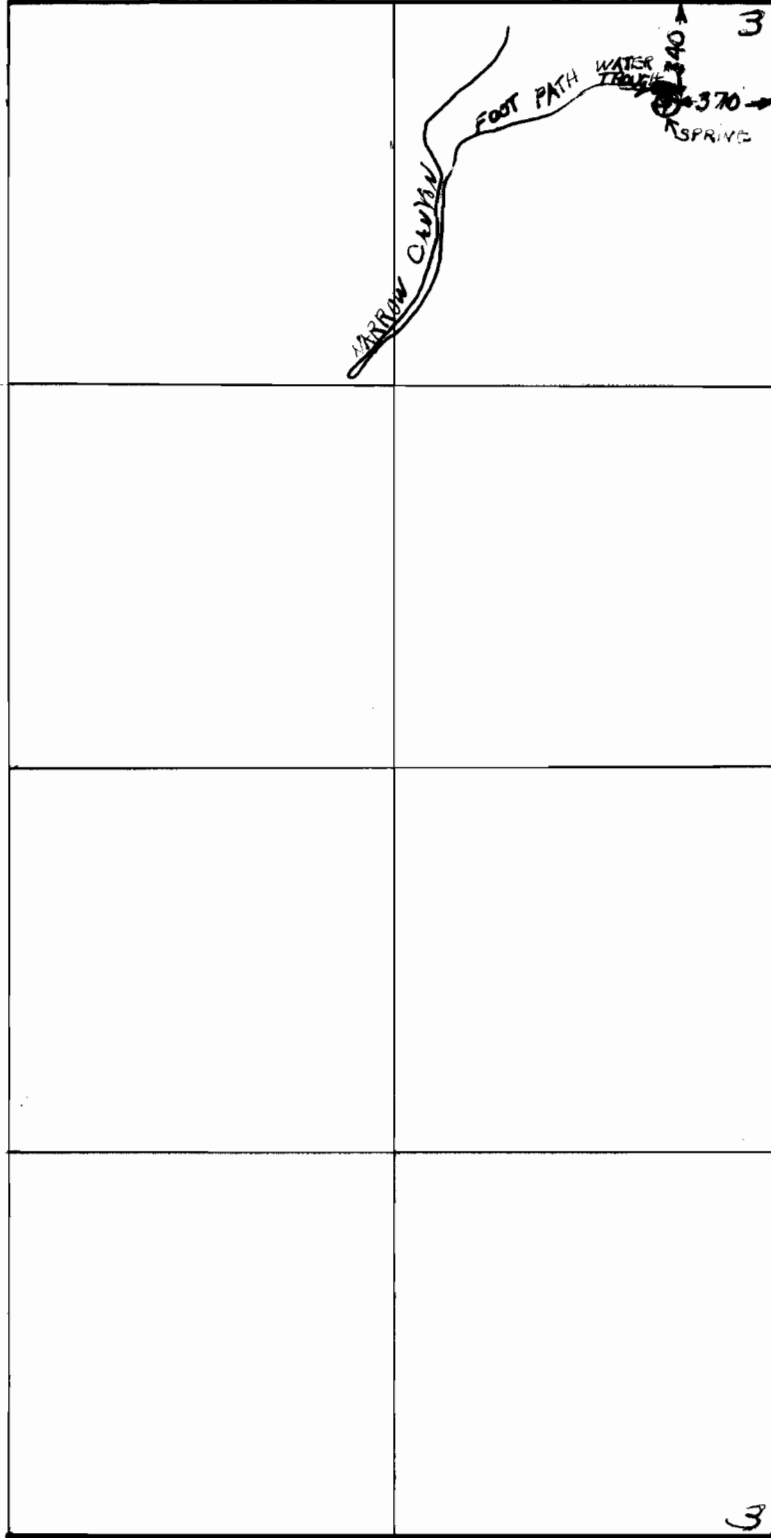

Application No. 63972
 Permit No. 47062

SCALE 8" = 1 MILE

RECEIVED
 AUG 30 1982
 WATER RESOURCES DIV.
 SALEM, OREGON