


SECTION 14

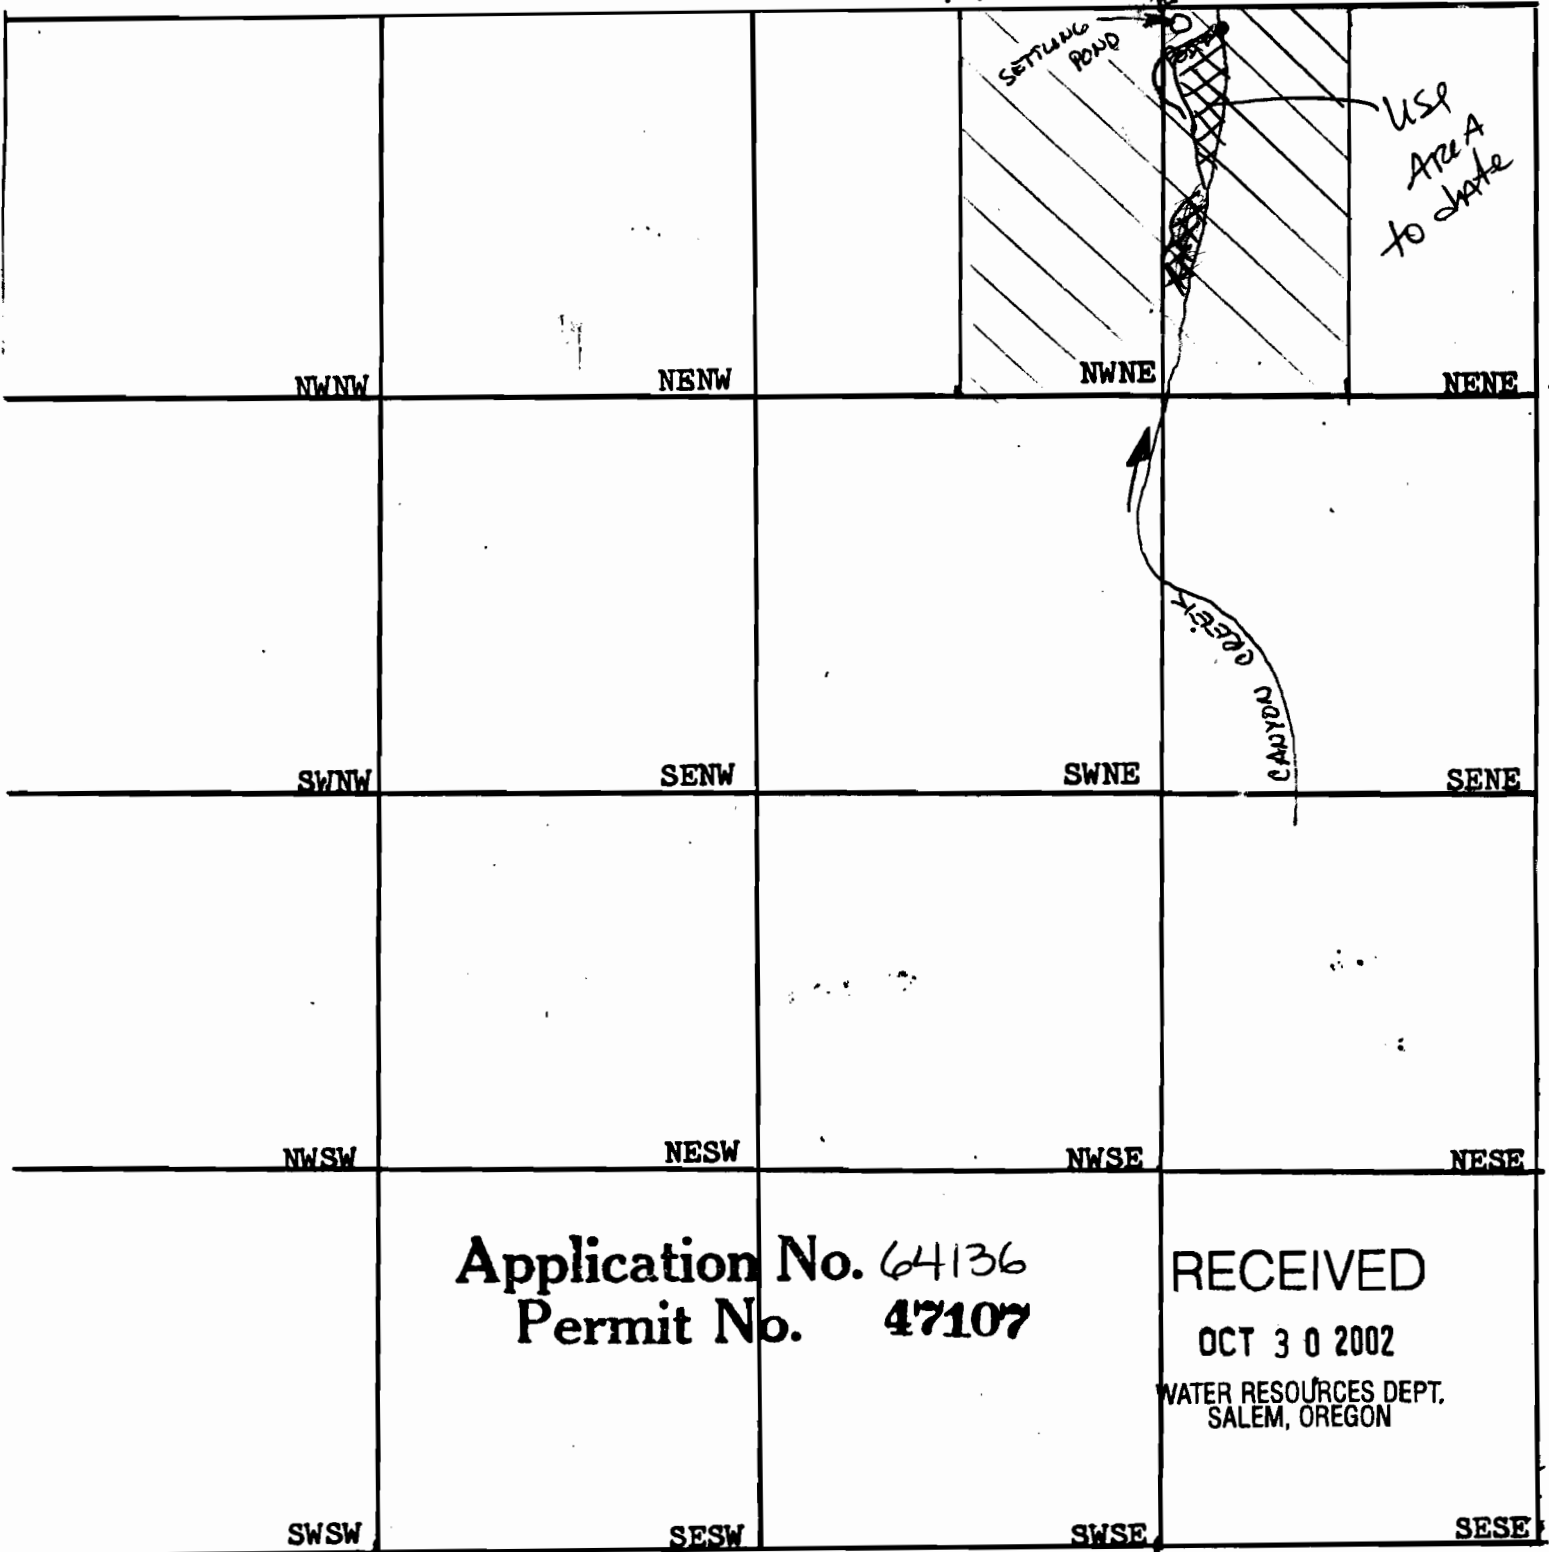

Scale: 8" - 1 Mile
2" - 1320 Ft.



DIVERSION POINT LOCATED: 50 feet South and 200 feet East from the E 1/16 corner sections 11 & 14

T14 S, R31 E

RECEIVED
SEP 9 1982
WATER RESOURCES DEPT.
SALEM, OREGON