


T.34S., R.6W.,W.M.

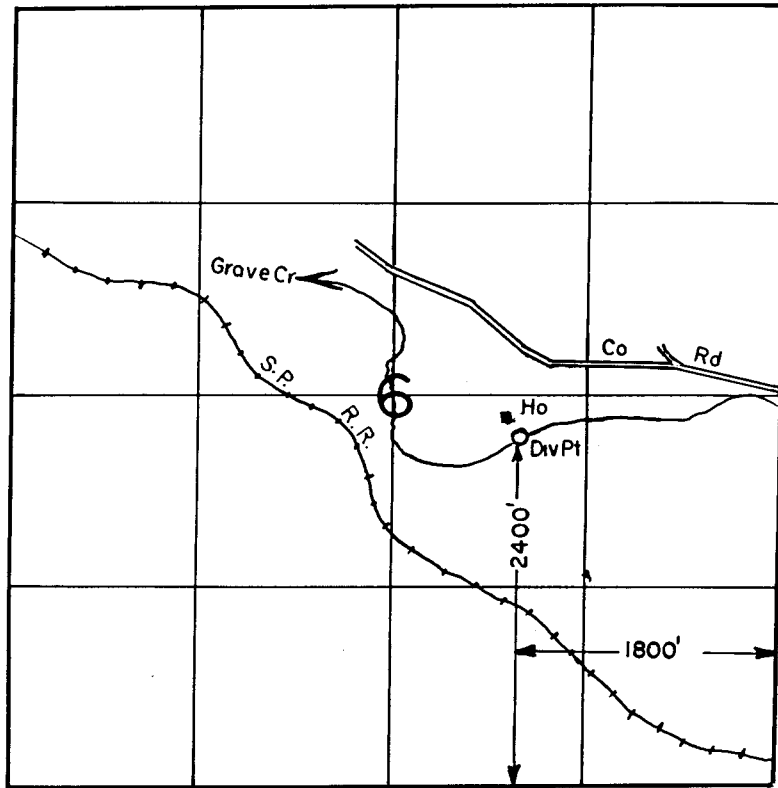

RECEIVED
 MAR 6 1991
 WM. DIST. 14
 GRANTS PASS. ORE.

SCALE: 1"=1320'

FINAL PROOF SURVEY UNDER

Application No. 63390.... Permit No. 47124.....
 IN NAME OF

.....**JAMES C CARTER**.....

Surveyed MAY 2.... 1989., by B.S. JAMES.....