


T.30S.R.4W.W.M.

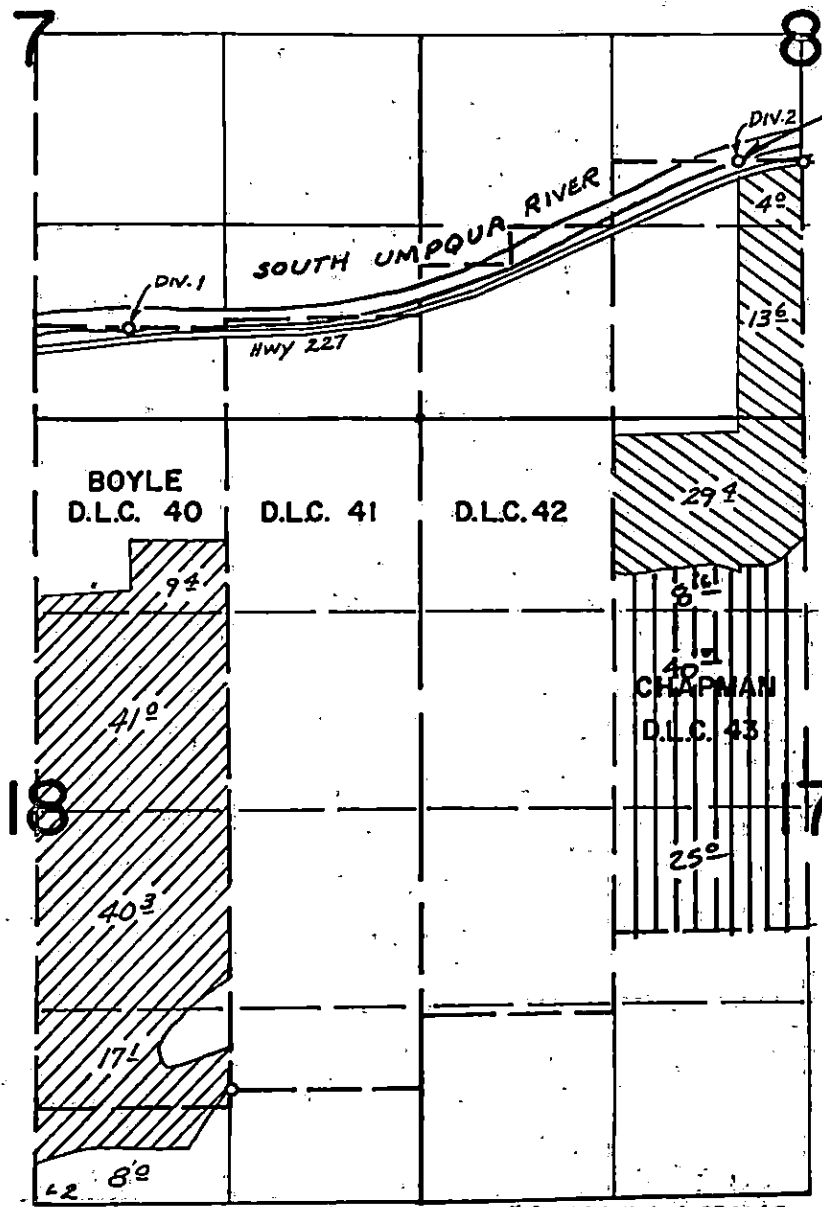

DIV. PT.
 1790' N. &
 2180' E.
 from 7 | 8
 18 | 17

DIV. PTS. LOC: #1 - 620' N. & 2000' W; #2 - 1750' N. & 2200' E,
 BOTH FROM S.E. COR. SEC. 7

~~FINAL PROOF SURVEY~~
 UNDER

Application No. 63175
 Permit No. 47148

Application No. 45673 Permit No. 34077
 IN NAME OF

[Hatched Box] = NEW APPLIN
 [Diagonal Lines Box]

GREEN VALLEY FARMS
 Surveyed MAY 12 1976., by L.E. GOULD.

RECEIVED
 OCT 11 1982
 WATER RESOURCES DEPT.
 SALEM, OREGON