
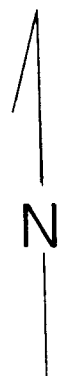


T.34S., R.6W., W.M.

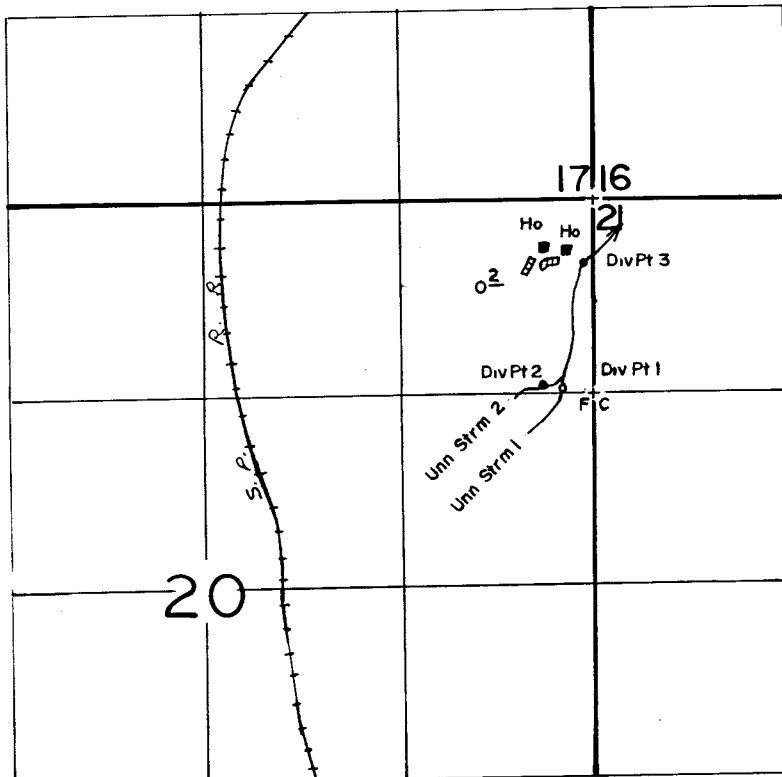

DIV. PTS. LOCATED - 1, 1300'S. & 200'W. - 2, 1290'S. & 330'W. - 3, 450'S. & 50'W
ALL FROM THE N.E. CORNER OF SECTION 20

RECEIVED
JUL 18 1991
WIS. DIST. #4
GRANT COUNTY REG.

SCALE: 1"=1320'

**FINAL PROOF SURVEY
UNDER**

Application No. 62748. Permit No. 47166.....
IN NAME OF

.....**BONNIE J. BAKER**.....

Surveyed **JUNE 13, 1989.** by **B.S. JAMES**.....