


T. 39 S., R. 8 W., W. M.

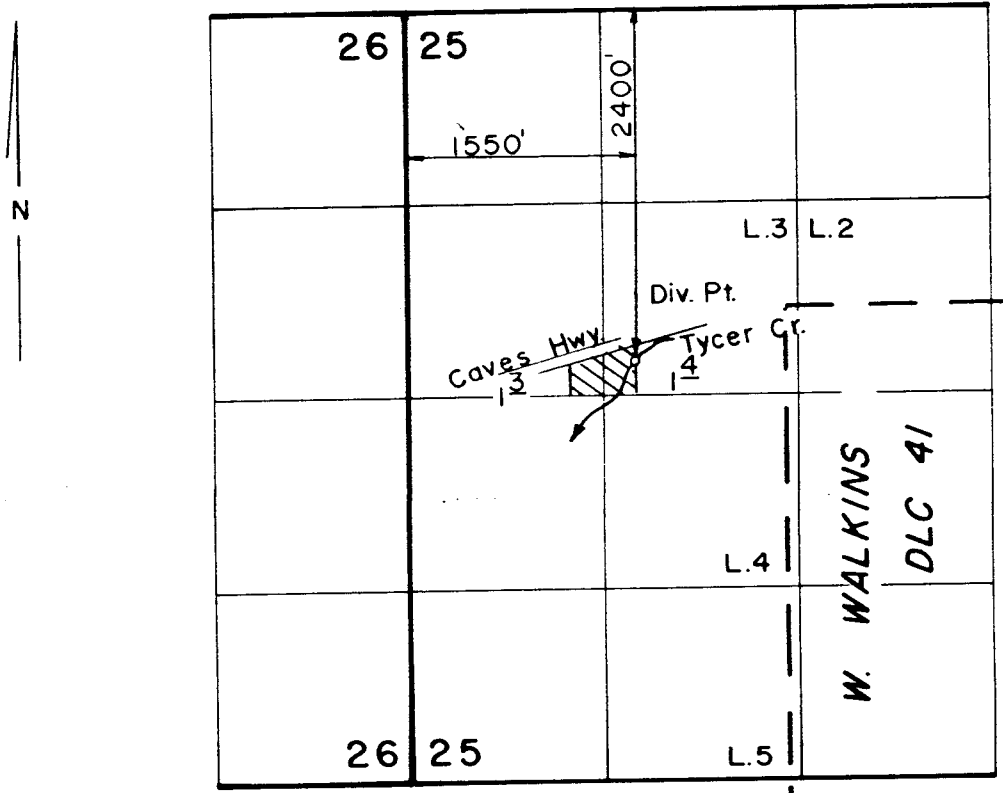

Scale: 1" = 1320'

**FINAL PROOF SURVEY**  
UNDER

Application No. 6.4.481 Permit No. 47.1.7.8...  
IN NAME OF

.....EARLY K. ELMORE.....

Surveyed May 14, 1986, by B. S. JAMES.

RECORDED

AUG 24 1989

REG. DIST. 14  

41833-179-1991 L.M.J.