


T. 8 S., R. 19 E., W.M.

APPLICATION MAP FOR

JON BOWERMAN

Jon Bowerman

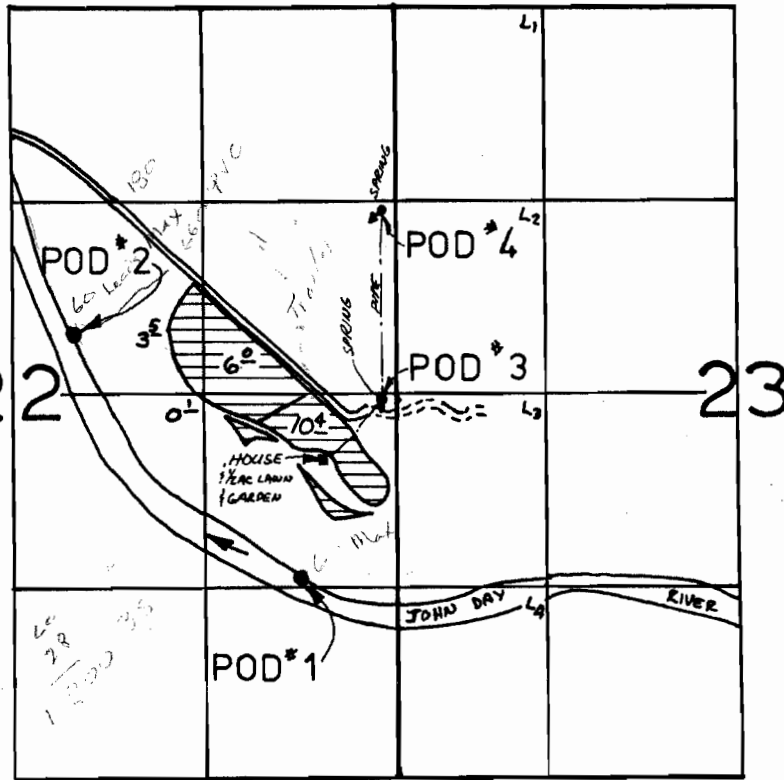

2- GE 15 hp @ 3500 rpm
2- Cornell 3x3 pump

SCALE
4" = 1 mi

RECEIVED

NOV 29 1982

WATER RESOURCES DEPT.
SALEM, OREGON

APPROVED

- POD#1 is to be located 1250 ft S & 650 ft W,
 - POD#2 is to be located 420 ft N & 2200 ft W,
 - POD#3 is to be located 50 ft S & 120 ft W,
 - POD#4 is to be located 1260 ft N & 100 ft W,
- all from the E $\frac{1}{4}$ corner of Sec.22, T8S, R19E, WM

RECEIVED

NOV 4 1982

WATER RESOURCES DEPT.
SALEM, OREGON

Application No. 64524
Permit No. 47231