


Application No. *23607*
Permit No. 47246T. 29 S. R. 6 W. S

9 10
16 15

1" = 400'

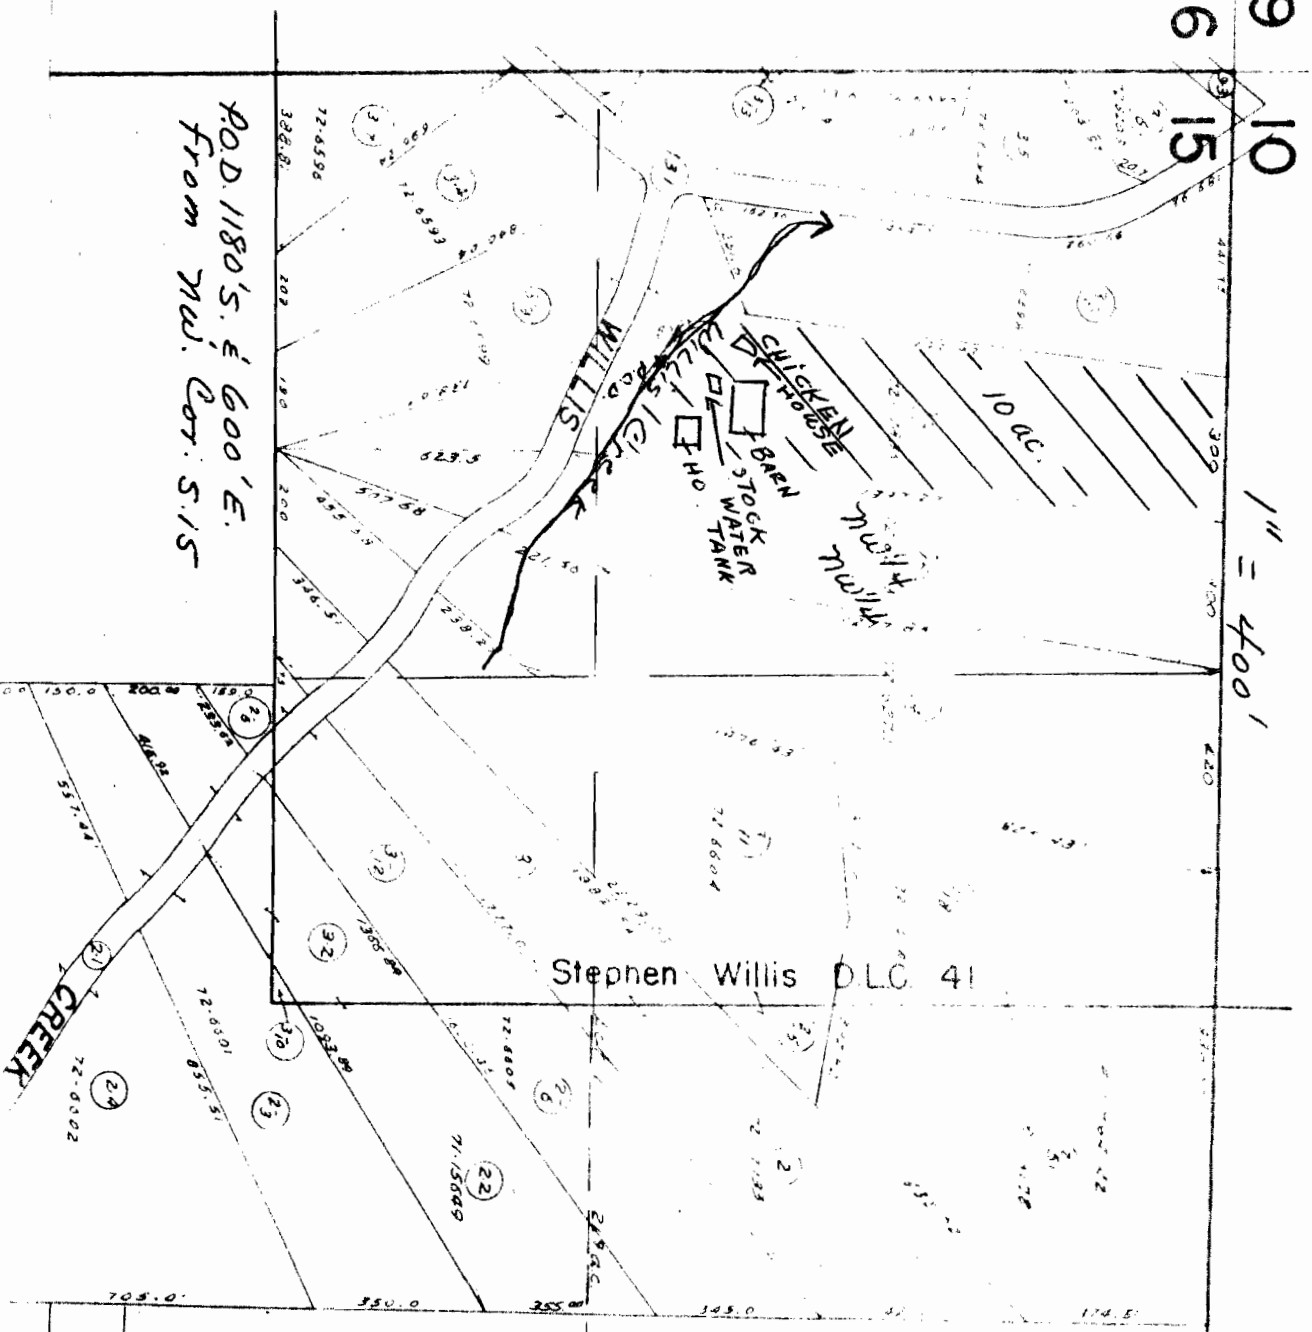

RECEIVED

DEC 20 1982

WATER RESOURCES DEPT.
SALEM, OREGON

RECEIVED

SEP 10 1981

WATER RESOURCES DEPT.
SALEM, OREGON