


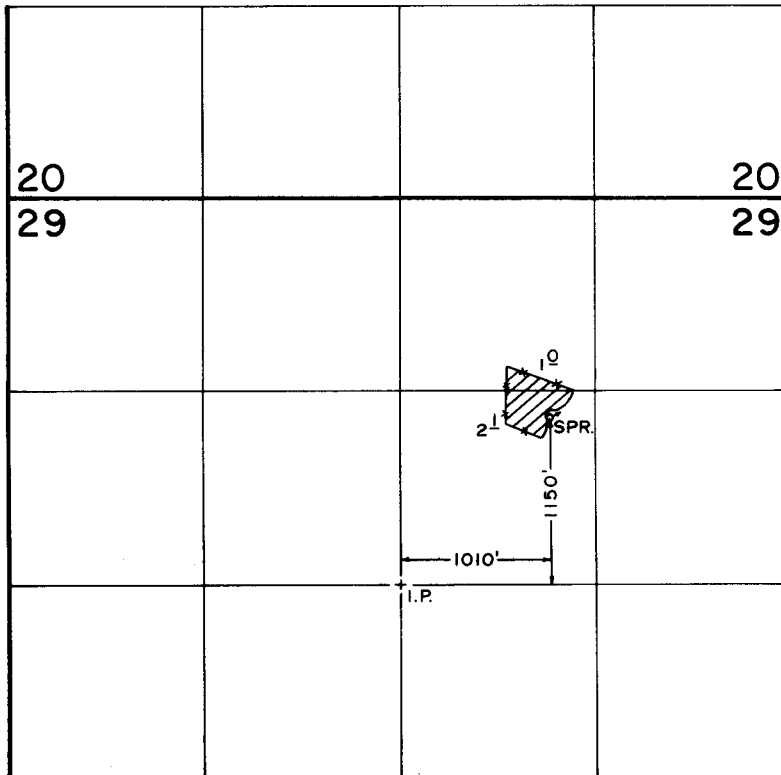

T. 37 S., R. 5 W., W.M.



RECEIVED

NOV 16 1990

WM. DIST. 14
GRANTS PASS, ORE.

SCALE: 1" = 1320'

FINAL PROOF SURVEY
UNDER

Application No. 64521... Permit No. 47285.....
IN NAME OF

ROBERT E. & LINDA F. WILEY

Surveyed MAY 24.. 1989.. by B. S. JAMES.....

11-28-89
41033-179-92 R