


CITY OF JEFFERSON

Application No. 64559
Permit No. 47330

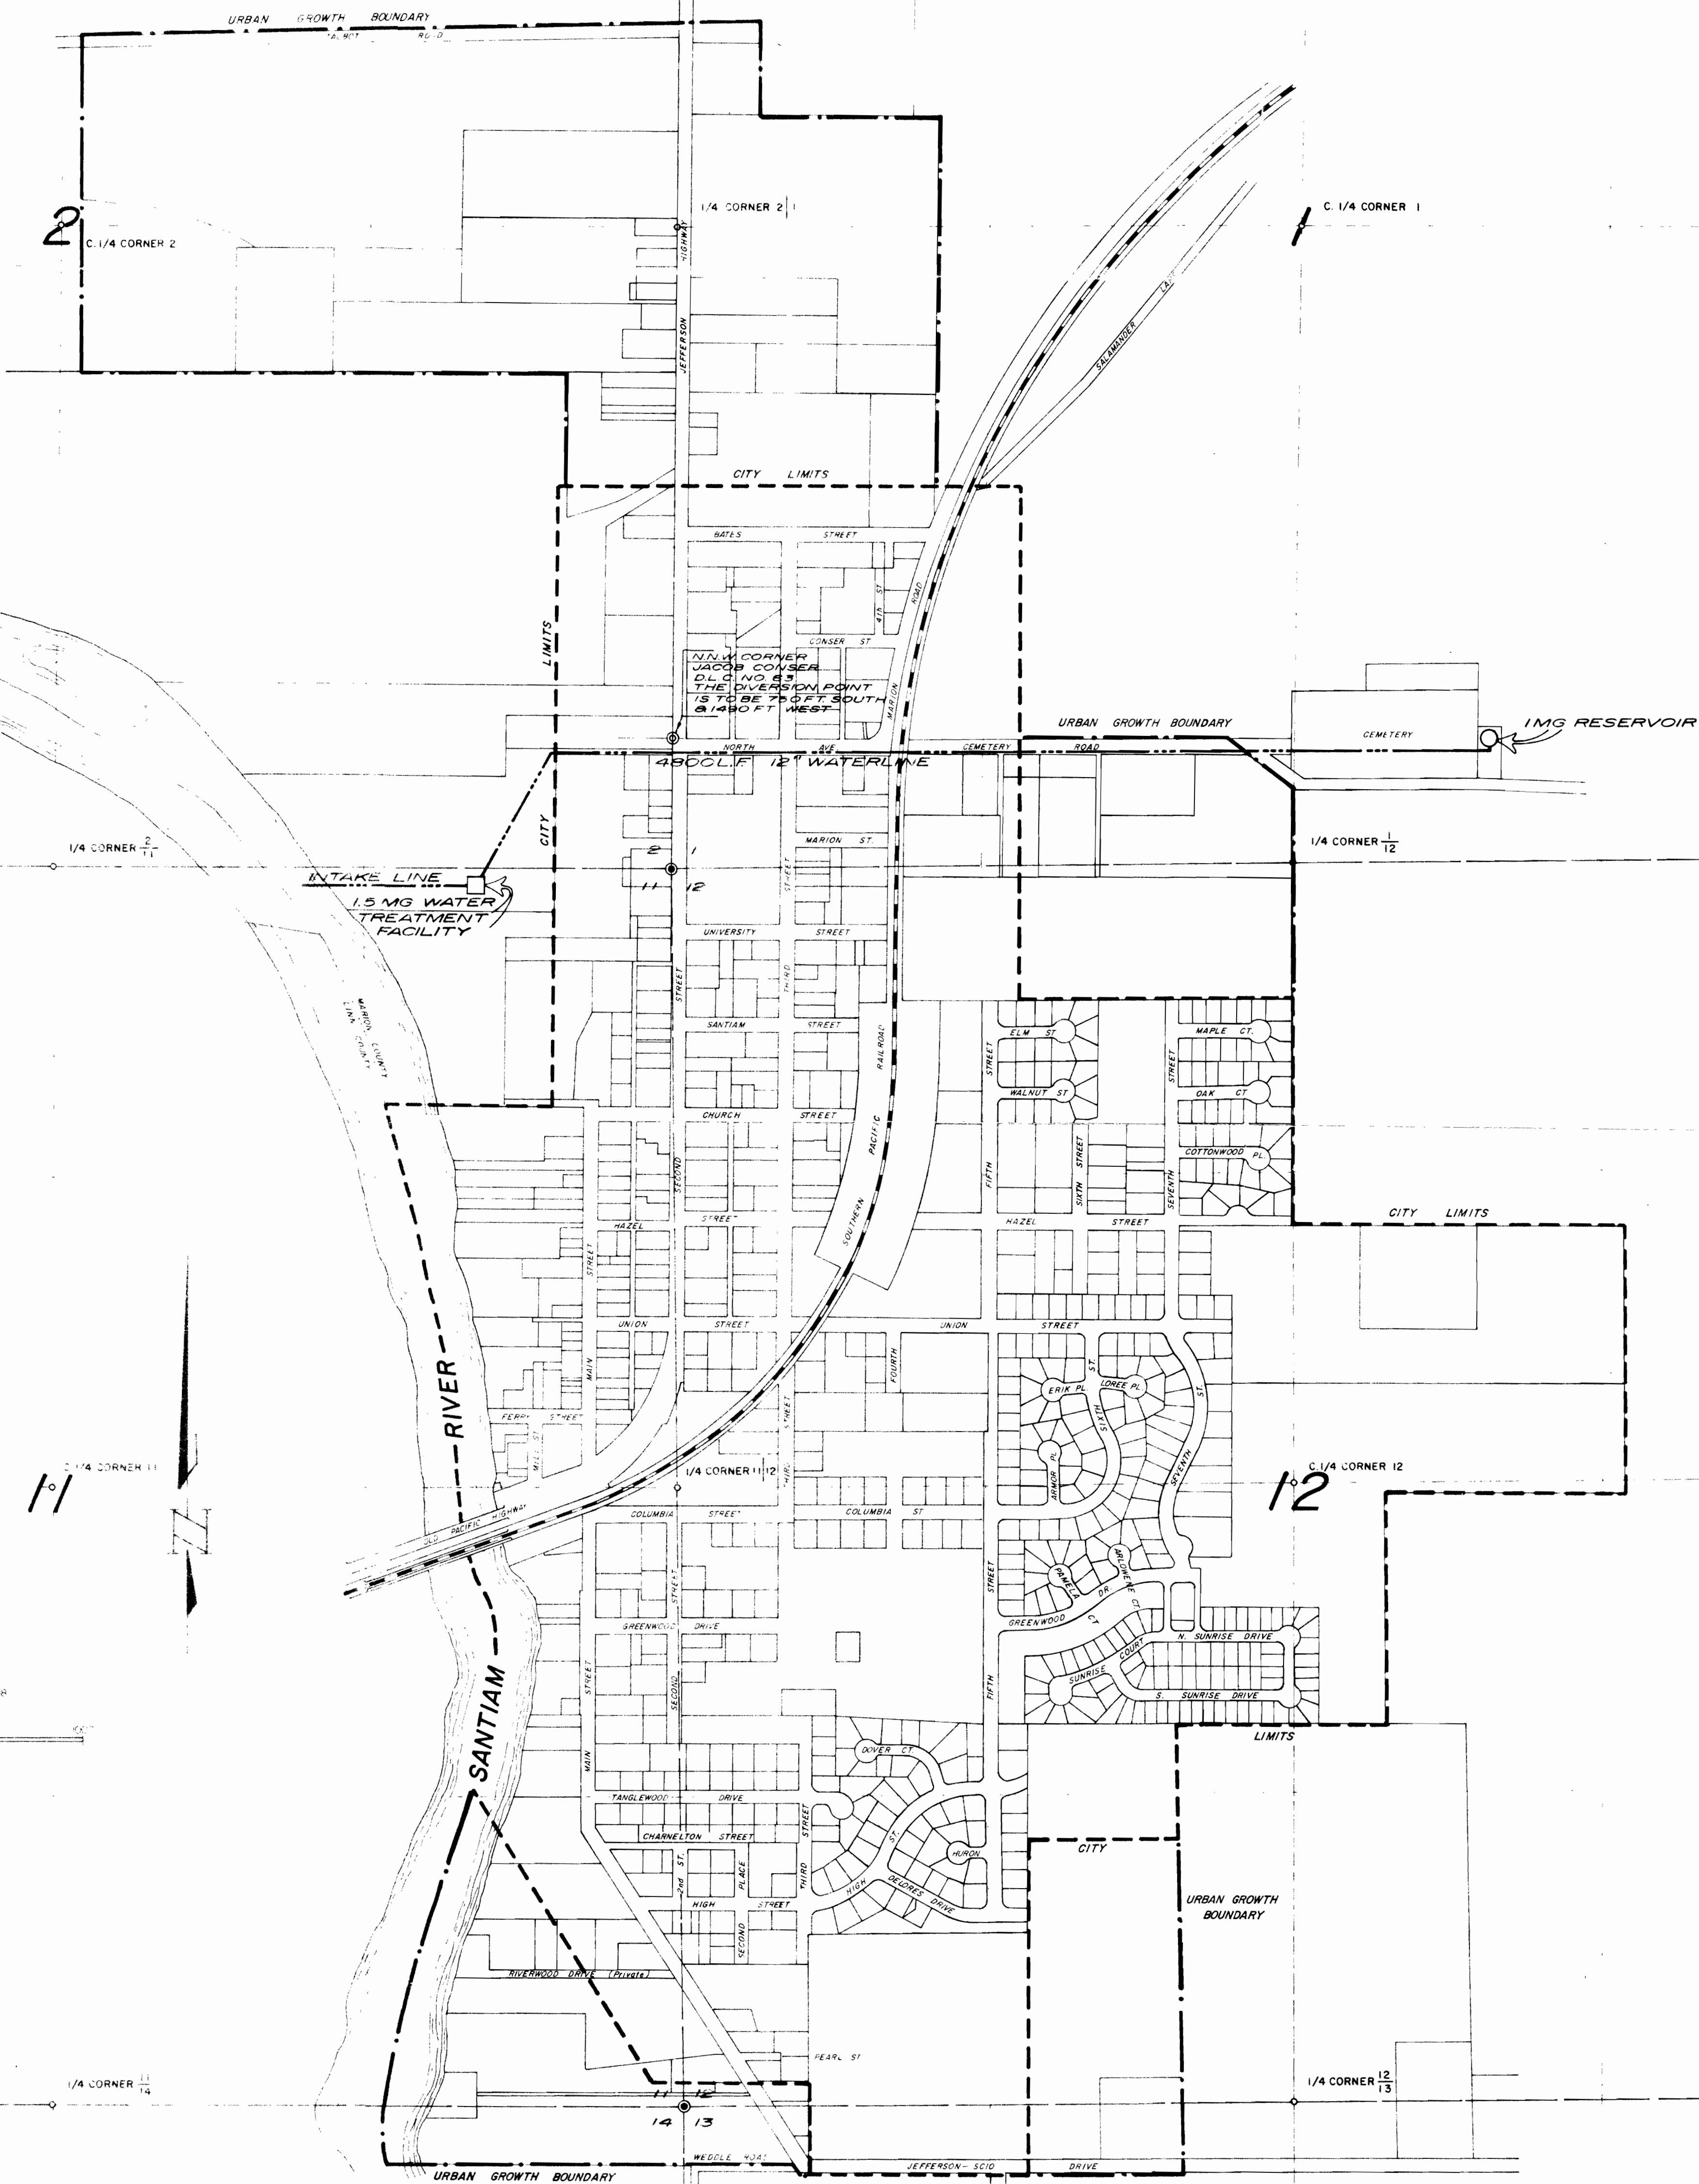

JANUARY 98

SCALE
1" = 400'

RECEIVED
FEB 2 1983
WATER RESOURCES DEPT.
SALEM, OREGON

**PROPOSED WATER SYSTEM IMPROVEMENTS FOR
THE CITY OF JEFFERSON, OREGON**