


T. 39 & 40 S., R. 8 W., W.M.

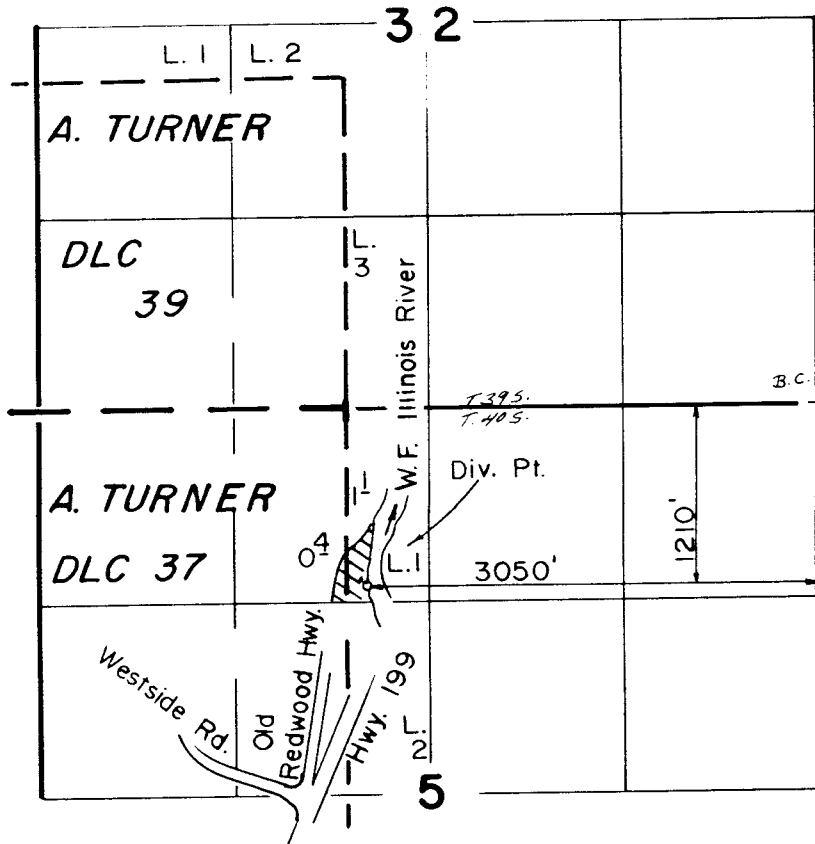

RECEIVED

AUG 24 1989

FINAL PROOF SURVEY
UNDER

Application No. 64560. Permit No. 47331.
IN NAME OF

JAMES L. FRICK

Surveyed MAY 7, 1986, by B. S. JAMES.

41033-179-2344 L.M.