


Application No. R 64572 & 64573
 Permit No. R 8597
 47335

T 28S R 7W W 1/4

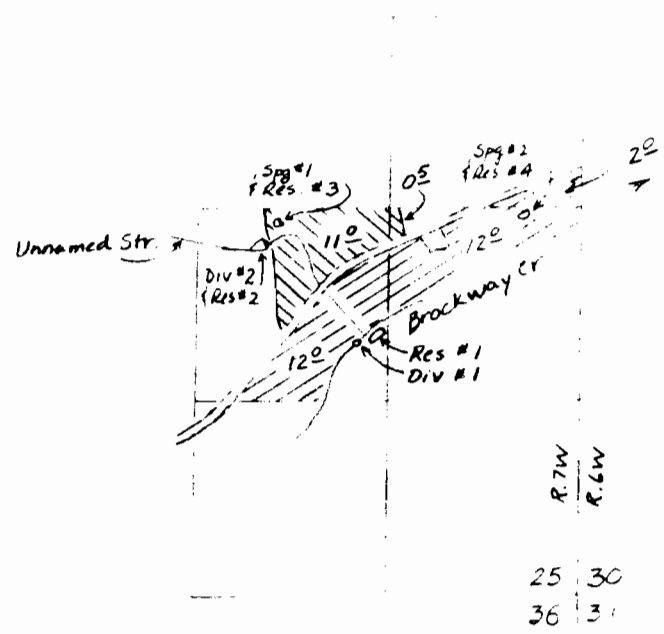

RECEIVED
 JAN 12 1983
 WATER RESOURCES DEPT.
 SALEM, OREGON

Scale 4" = 1 mile



To be irrigated from Unnamed Str. Spq #1 Res #2, Res #3



To be irrigated from Brockway Cr. Spq #2, Res #1, Res #4

Div #1	1790' N	1380' W	} From SE Cor Sec 5
Div #2	2400' N	2170' W	
Spq #1	2560' N	2080' W	
Spq #2	2600' N	370' W	

RECEIVED RECEIVED

Application No. 64573
 Permit No.

JAN 26 1983
 WATER RESOURCES DEPT. WATER RESOURCES DEPT.
 SALEM, OREGON SALEM, OREGON
 DEC 7 1982