


T 185 R 8W  
1" = 400'

ELECTRIC  
1RB

Application No. 63498  
Permit No. 47361

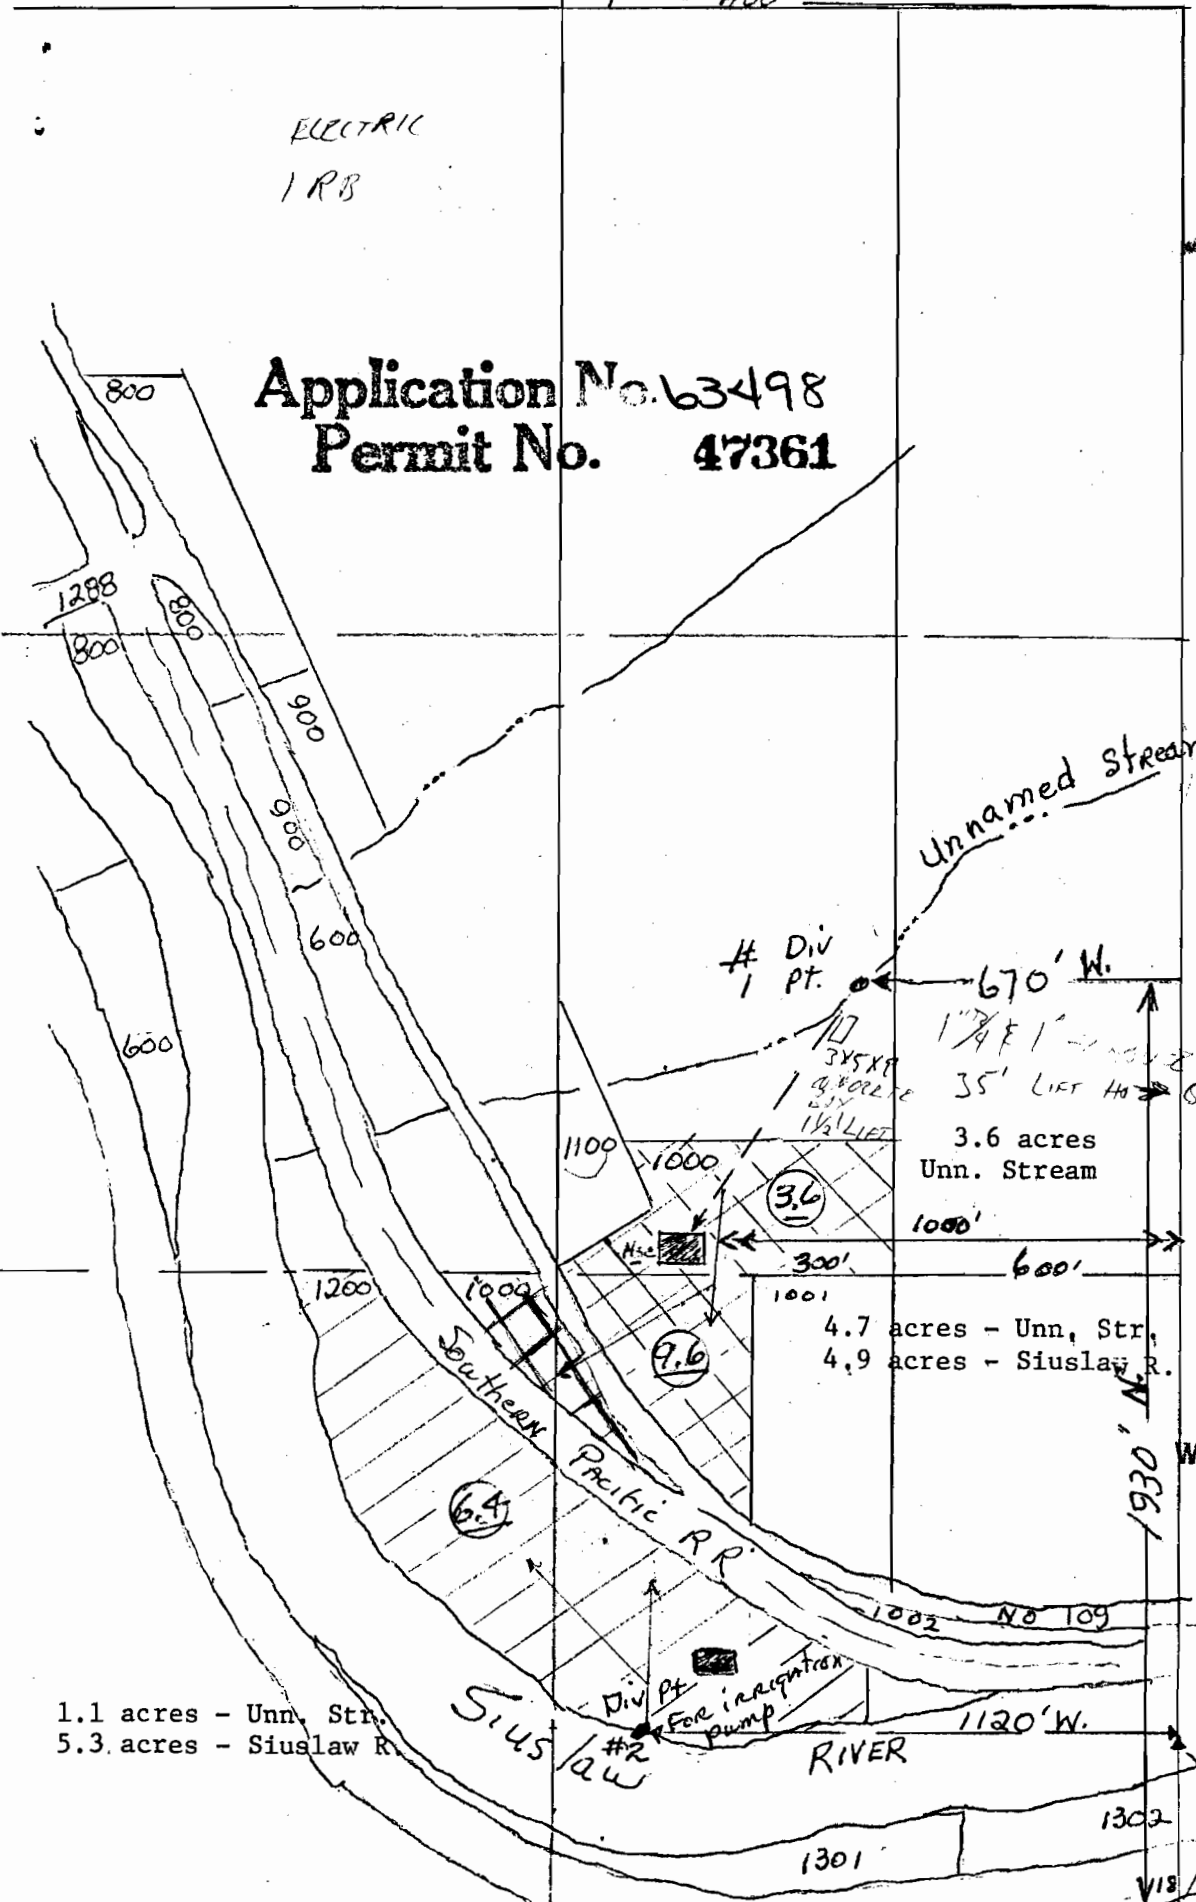

**RECEIVED**  
FEB 3 1983  
WATER RESOURCES DEPT.  
SALEM, OREGON

**RECEIVED**  
APR 29 1982  
WATER RESOURCES DEPT.  
SALEM, OREGON

1.1 acres - Unn. Str.  
5.3 acres - Siuslaw R.

1302 360' N.  
1930' N.  
1000' 600' 300' 1000'  
1200' 1000' 1100' 1000' 1288 800  
