


SECTION

14 SE SW

4 1 0 9

TOWNSHIP 16 S, RANGE 36 E, W. M.

North

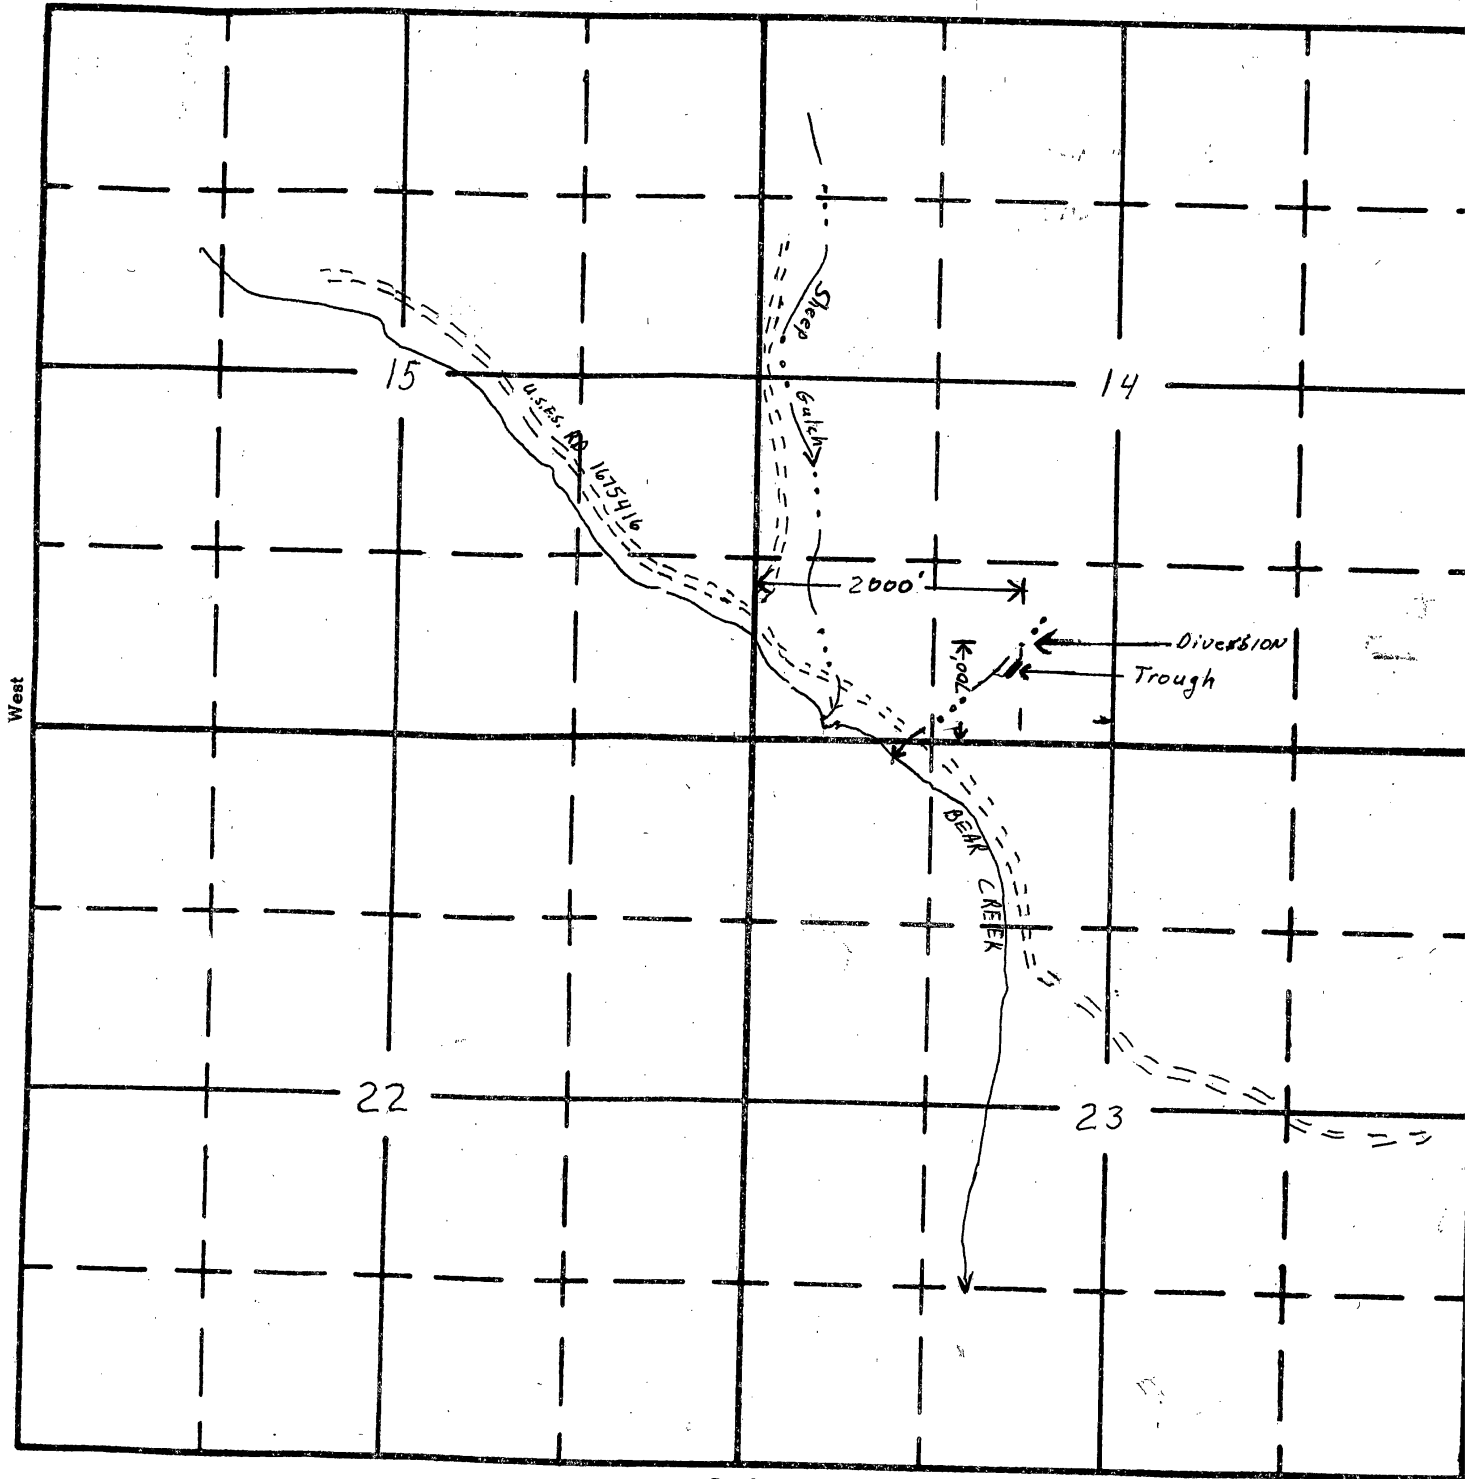

South

**RECEIVED**

JAN 17 1983

WATER RESOURCES DEPT.  
SALEM, OREGON

APPLICATION No. 62085

PERMIT No.

47395