



T. 34 S., R. 5 W., W.M.

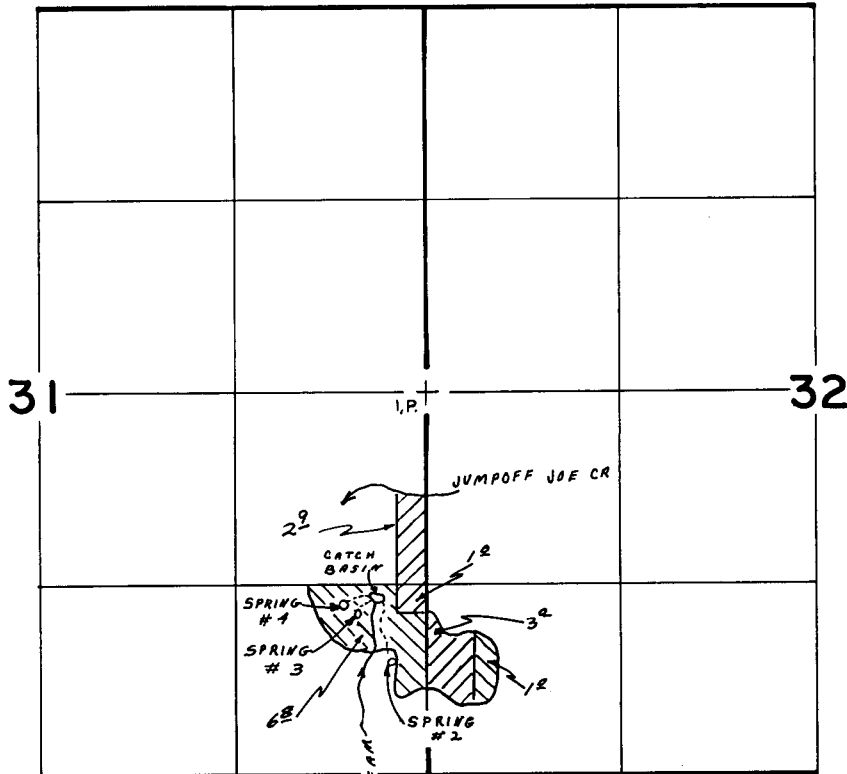

SCALE:  
1" = 1320'

DIVERSIONS:

- (1) Unnamed Stream = 1450' S., 350' W.;
  - (2) Spring = 1850' S., 260' W.;
  - (3) Spring = 1500' S., 470' W.;
  - (4) Spring = 1450' S., 575' W.;
- From E. 1/4 Cor. Sec. 31

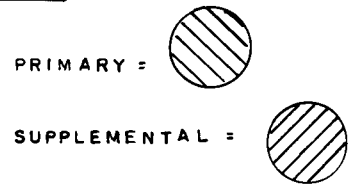

**FINAL PROOF SURVEY**  
UNDER

Application No. 6.442.4 Permit No. 4.742.1....  
IN NAME OF

**ARNOLD A. & CATHERINE PITTS**

Surveyed JUL. 12. 1985, by B. S. JAMES.

RECORDED  
DEC 17 1986  
VAL. OFF. OF  
GRANTS FILED, DEC.