


RECEIVED

DEC 22 1982

WATER RESOURCES DEPT.
SALEM, OREGON

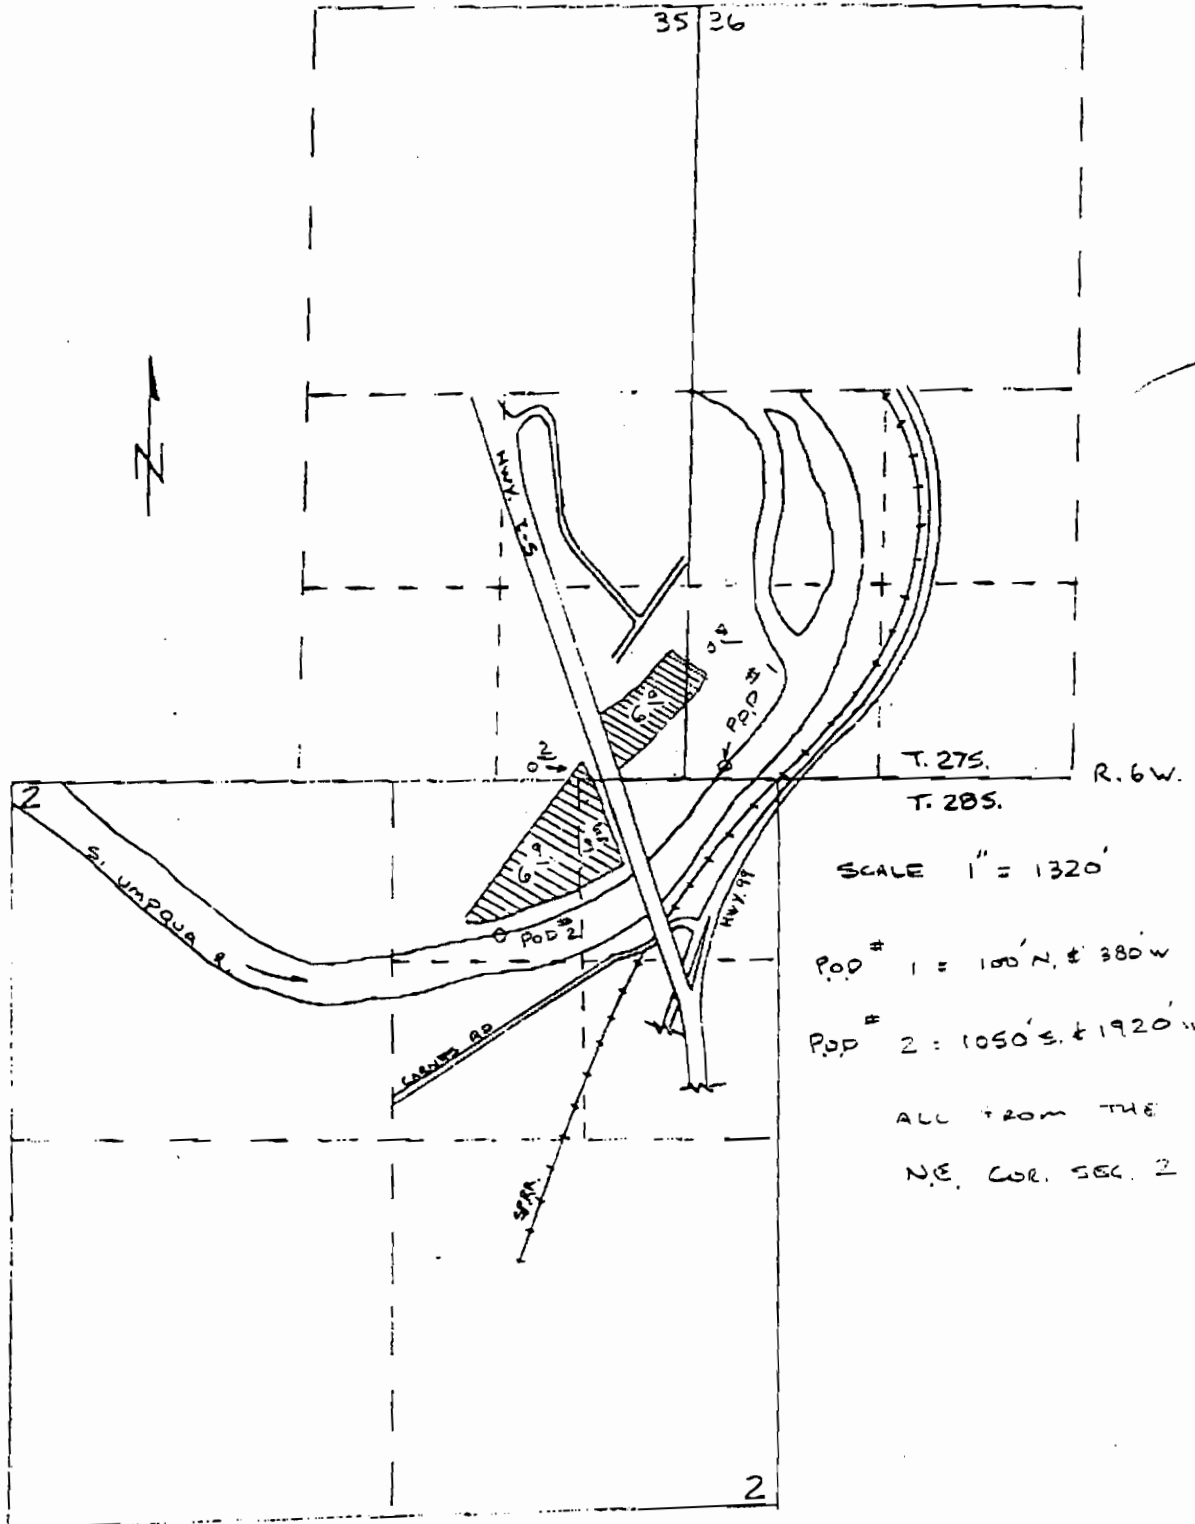

Application No. 64588

Permit No. 47437