


T. 38 S., R. 5 W., W. M.

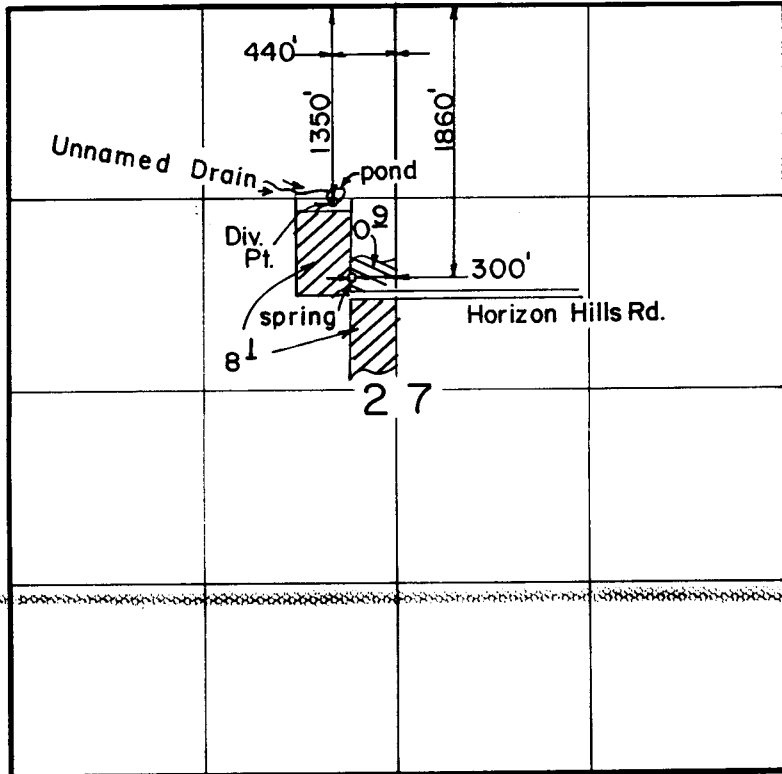

Scale: 1" = 1320'

RECEIVED

MAY 6 1991

FINAL PROOF SURVEY UNDER

WM. DIST. 14
GRANTS PASS, ORE.

Application No. 62980. Permit No. 47443...
IN NAME OF

.....NOEL.....M.....MANCHESTER.....

Surveyed AUG. 9..... 1988., by B.....S.....JAMES.....

4123-179-1082

LMS
5/89