


Permit: S 47444
Volume: 1
Strm: ROGUE R
Trib: PACIFIC OCEAN
Priority: 3/01/83

T. 36 S., R. 6 W., W. M.

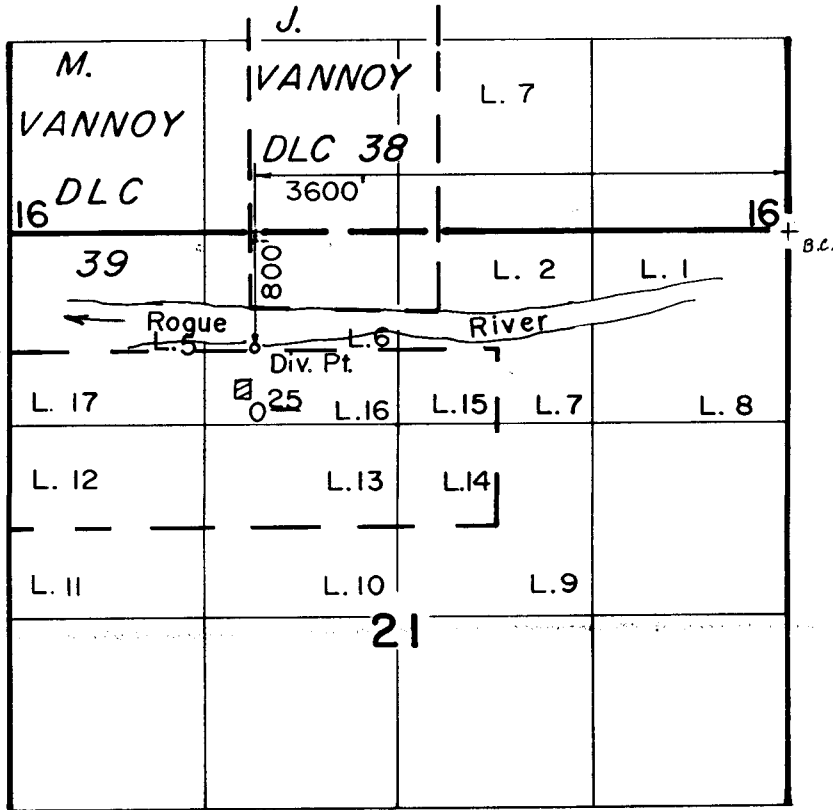

Scale: 1" = 1320'

RECEIVED
JUL 23 1990
WM DIST. 14
GRANTS PASS, ORE.

FINAL PROOF SURVEY UNDER

TRANSFER NO. 5138

Application No. 62985 Permit No. 47444.
IN NAME OF

.....SOLVEIG W. LOZIER.....

Surveyed Sep. 21, 1987, by B. S. JAMES..