

RECEIVED

APR 22 1983


WATER RESOURCES DEPT.
SALEM, OREGON

T.6 S.R.13&14 E.W.M.

RECEIVED

MAR 24 1983

WATER RESOURCES DEPT.
SALEM, OREGON

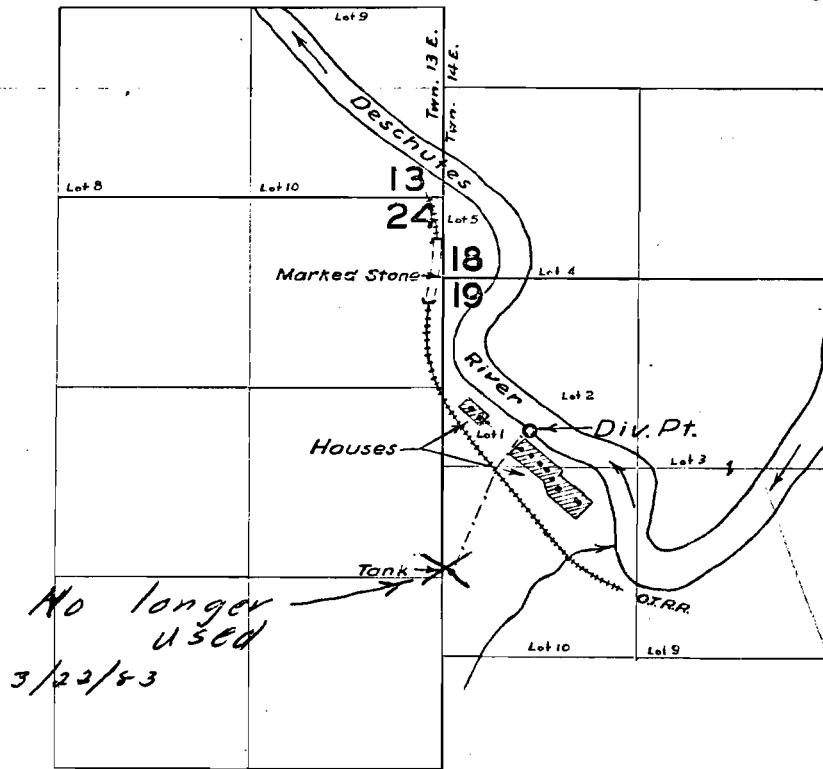

Application No. 64953

Permit No. 47507

FINAL PROOF SURVEY
UNDER

Application No. 21741... Permit No. 17109...
IN NAME OF

DESCHUTES HOME OWNERS ASSOC.

Surveyed 14 Nov. 1959, by M. Bish