


T.4S.R.2 E.W.M.

Application No. 63574  
Permit No. 47512

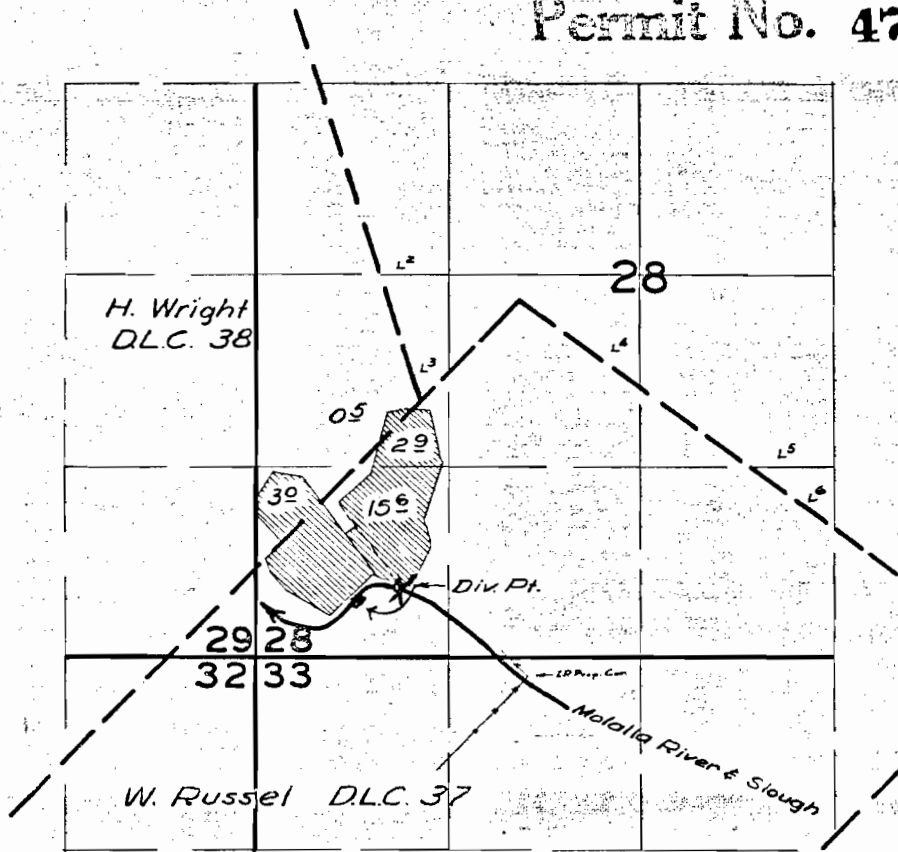

diverston point 400 ft N & 60 ft E of  
SW corner Sec 28

~~FINAL PROOF SURVEY  
-UNDER-~~

**RECEIVED**

MAY 25 1982

WATER RESOURCES DEPT.  
SALEM, OREGON

~~Application No. 31376 Permit No. 24738~~

~~IN NAME OF~~

~~DONALD JANNUZZI~~

~~Surveyed 21 Aug 1958, by M. Bush~~