


T. 265. R. 12 W.

RECEIVED

JUN 16 1981
WATER RESOURCES DEPT.
SALEM, OREGON

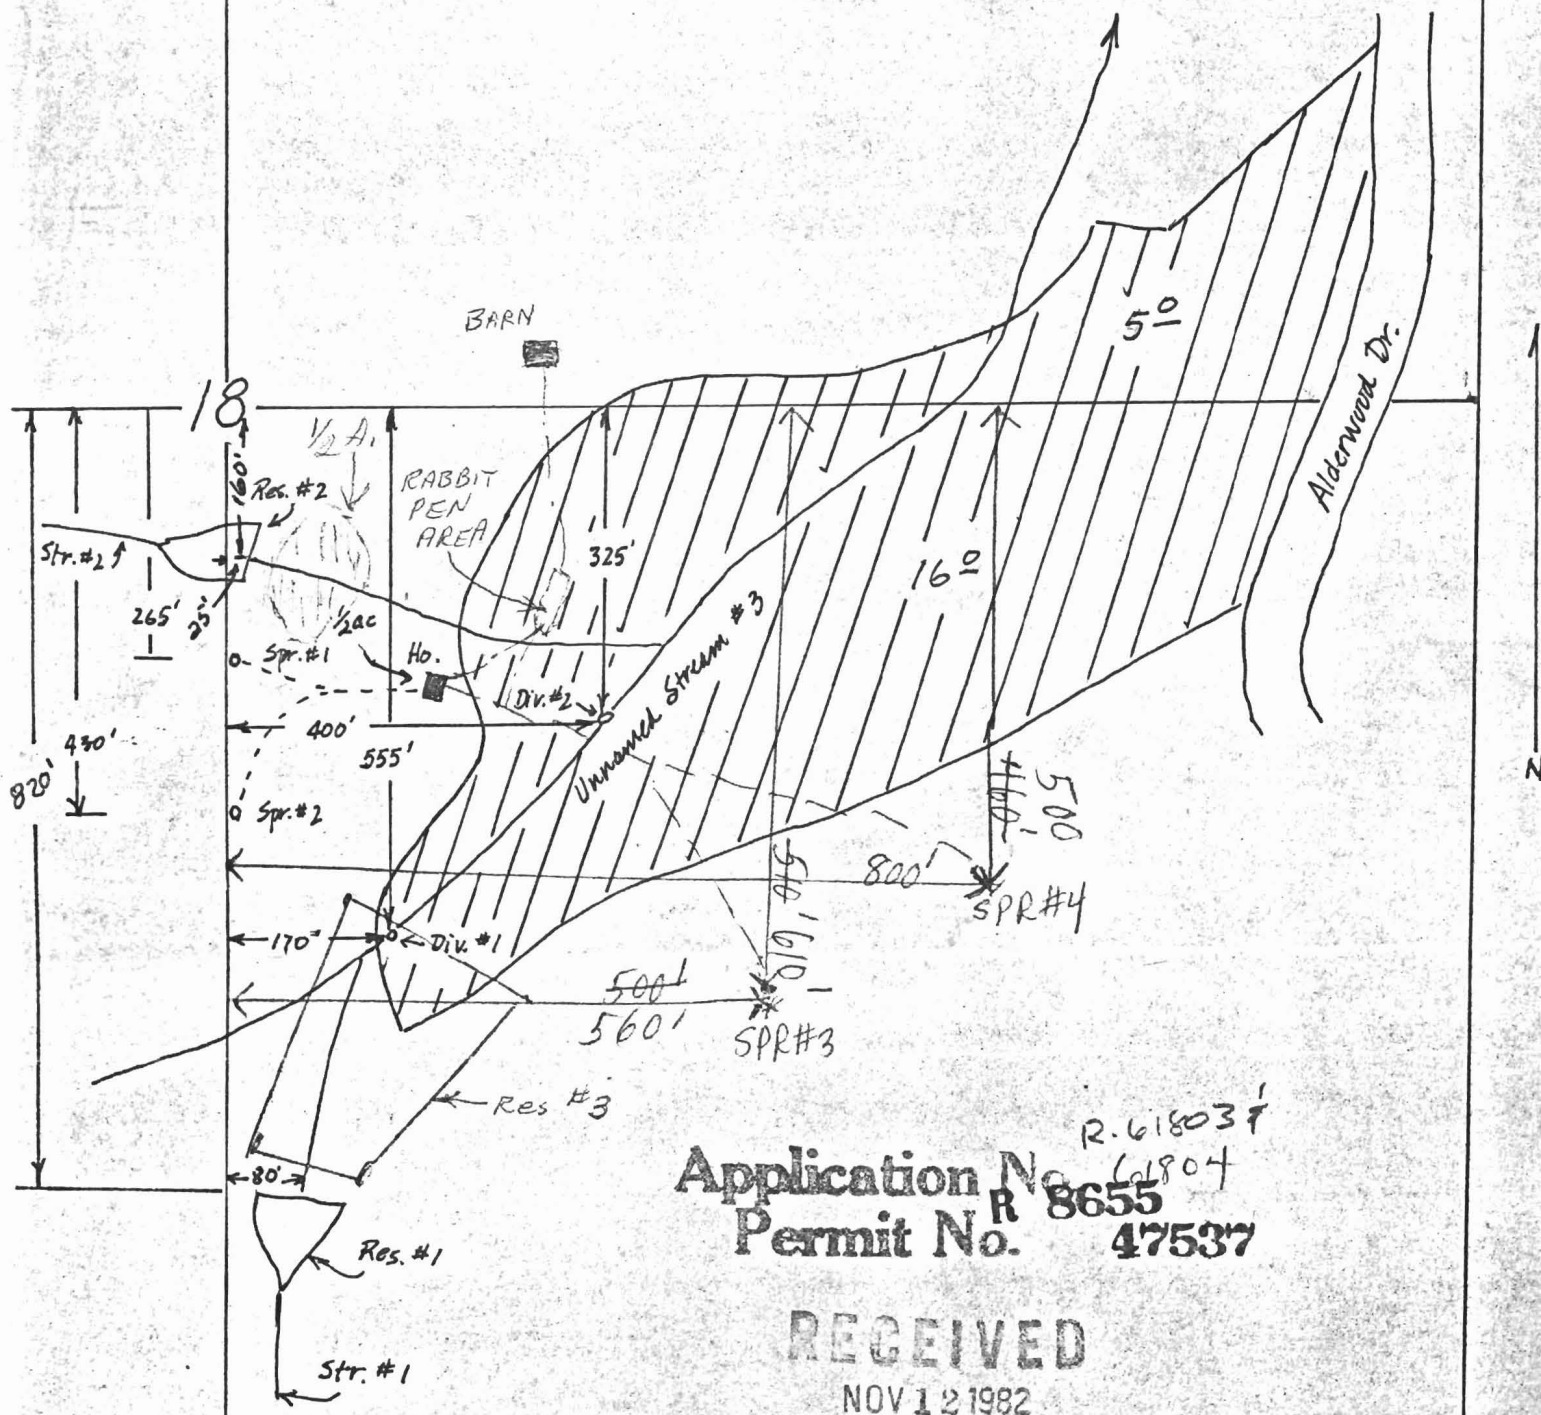

Application No. R 8655
Permit No. 47537

R. 618037
61804

RECEIVED

NOV 12 1982
WATER RESOURCES DEPT.
SALEM, OREGON