


T. 40 S., R. 7 W., W. M.

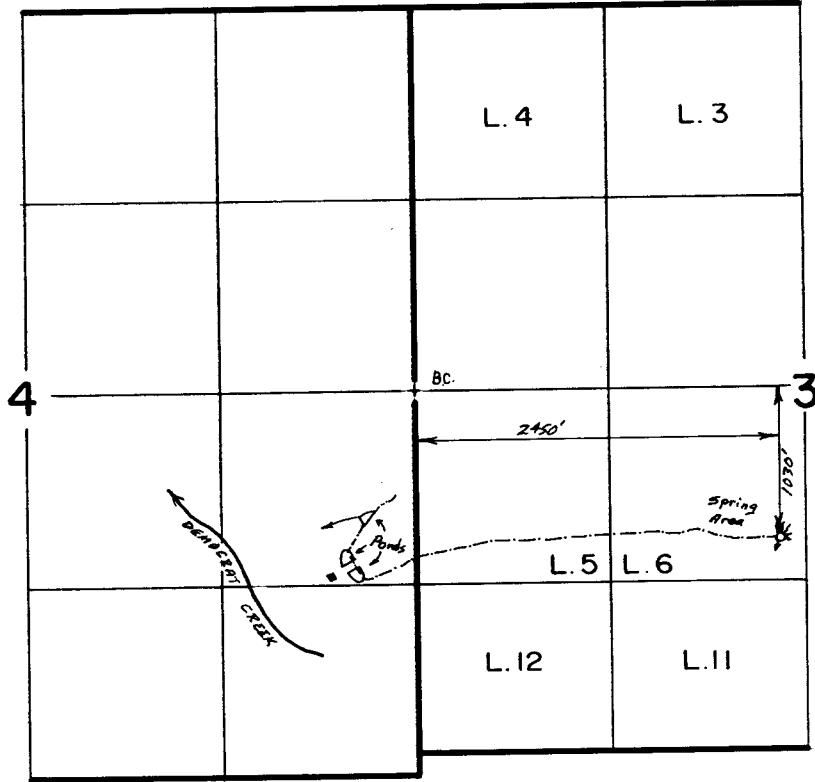

Scale: 1" = 1320'

RECEIVED

JUL 18 1991

WM. DIST. 14  
GRANTS PASS, ORE.

**FINAL PROOF SURVEY**  
UNDER

Application No. 64796 Permit No. 47545  
IN NAME OF

CHARLIE TREFETHEN

Surveyed MAY...15.. 19.8.6, by B...S...JAMES...

11033-179-1784

R.S.J.