

T. 8 S., R. 25 E., W.M.

RECEIVED


MAY - 2 1997

WATER RESOURCES DEPT.
SALEM, OREGON

RECEIVED

MAR 14 1983

WATER RESOURCES DEPT.
SALEM, OREGON

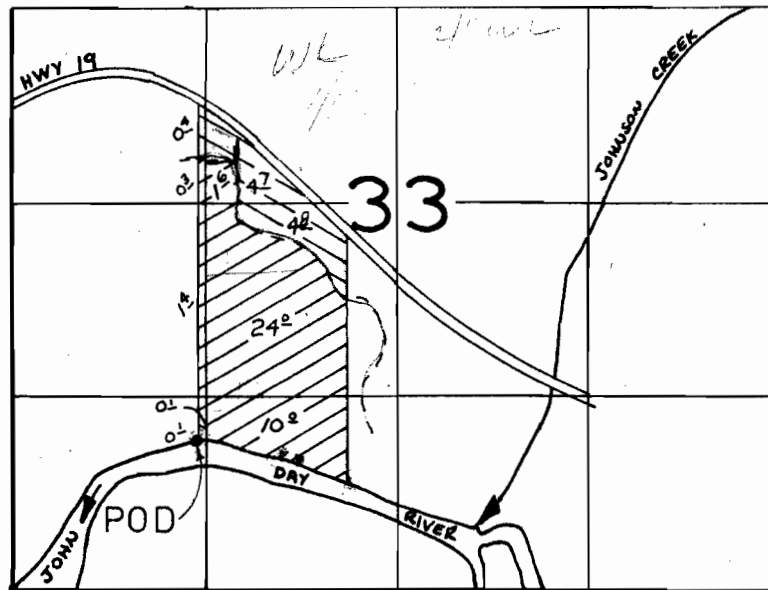

 C-35285 John Day River & Johnson Creek

 New Land this application

POD is 1040' North and 1240' East of SW corner Section 33,
T. 8 S., R. 25 E., W.M.

862' N x 2970' W of SE corner Sec 33

RECEIVED

FEB 11 1983

WATER RESOURCES DEPT.
SALEM, OREGON

Application No. 64840
Permit No. 47552