


T. 39 S., R. 8 W., W. M.

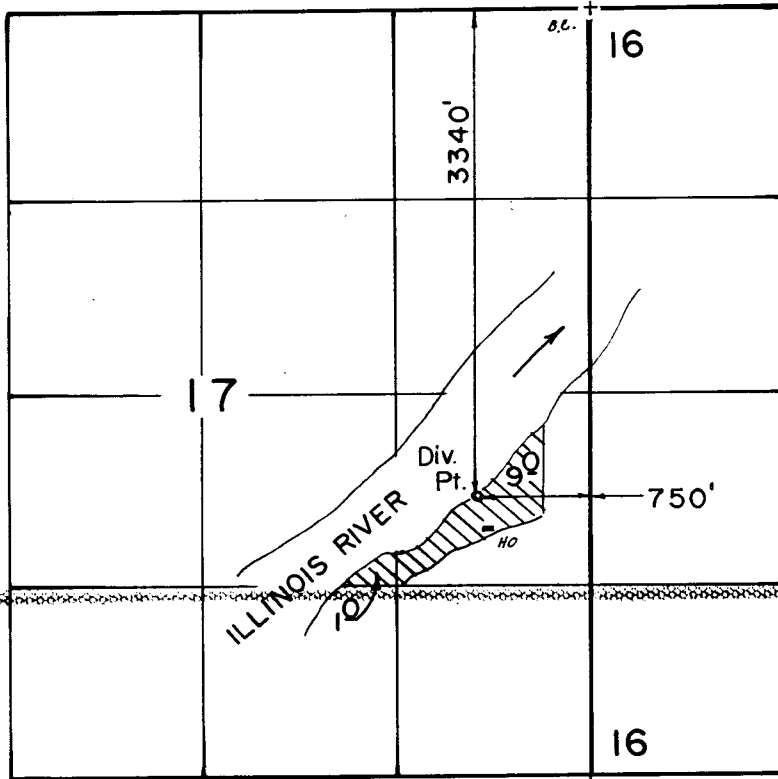

Scale: 1" = 1320'

RECEIVED  
MAY 6 1991

**FINAL PROOF SURVEY**  
UNDER

WM. DIST. 14  
C. N. VERSTEEG

Application No. 65138 Permit No. 47580  
IN NAME OF

.....C. N. VERSTEEG.....

Surveyed M.A.Y. 17 1988, by B. S. JAMES....