


T. 37 S., R. 5 W., W. M.

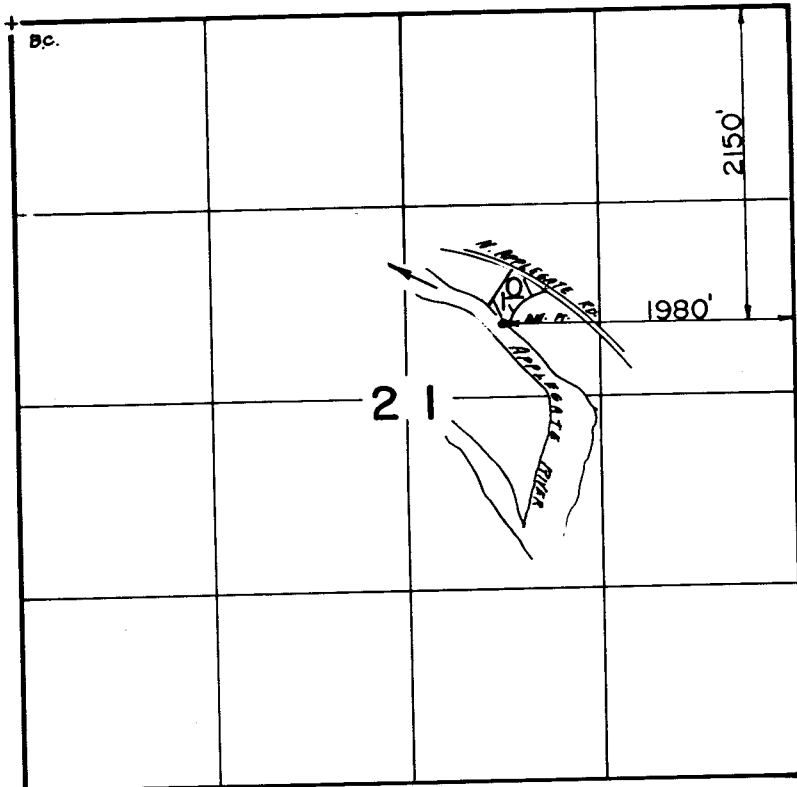

Scale: 1" = 1320'



RECEIVED
 APR 24 1991
 WM. DIST. 14
 GRANTS PASS, ORE.

FINAL PROOF SURVEY
 UNDER

Application No. 64944 Permit No. 47595
 IN NAME OF

DOROTHY CATHEY

Surveyed AUG. 23. 1988., by B. S. JAMES.