NE1/4 SEC. 24 T.26S. R.13W. W.M.
COOS COUNTY

1"-200'
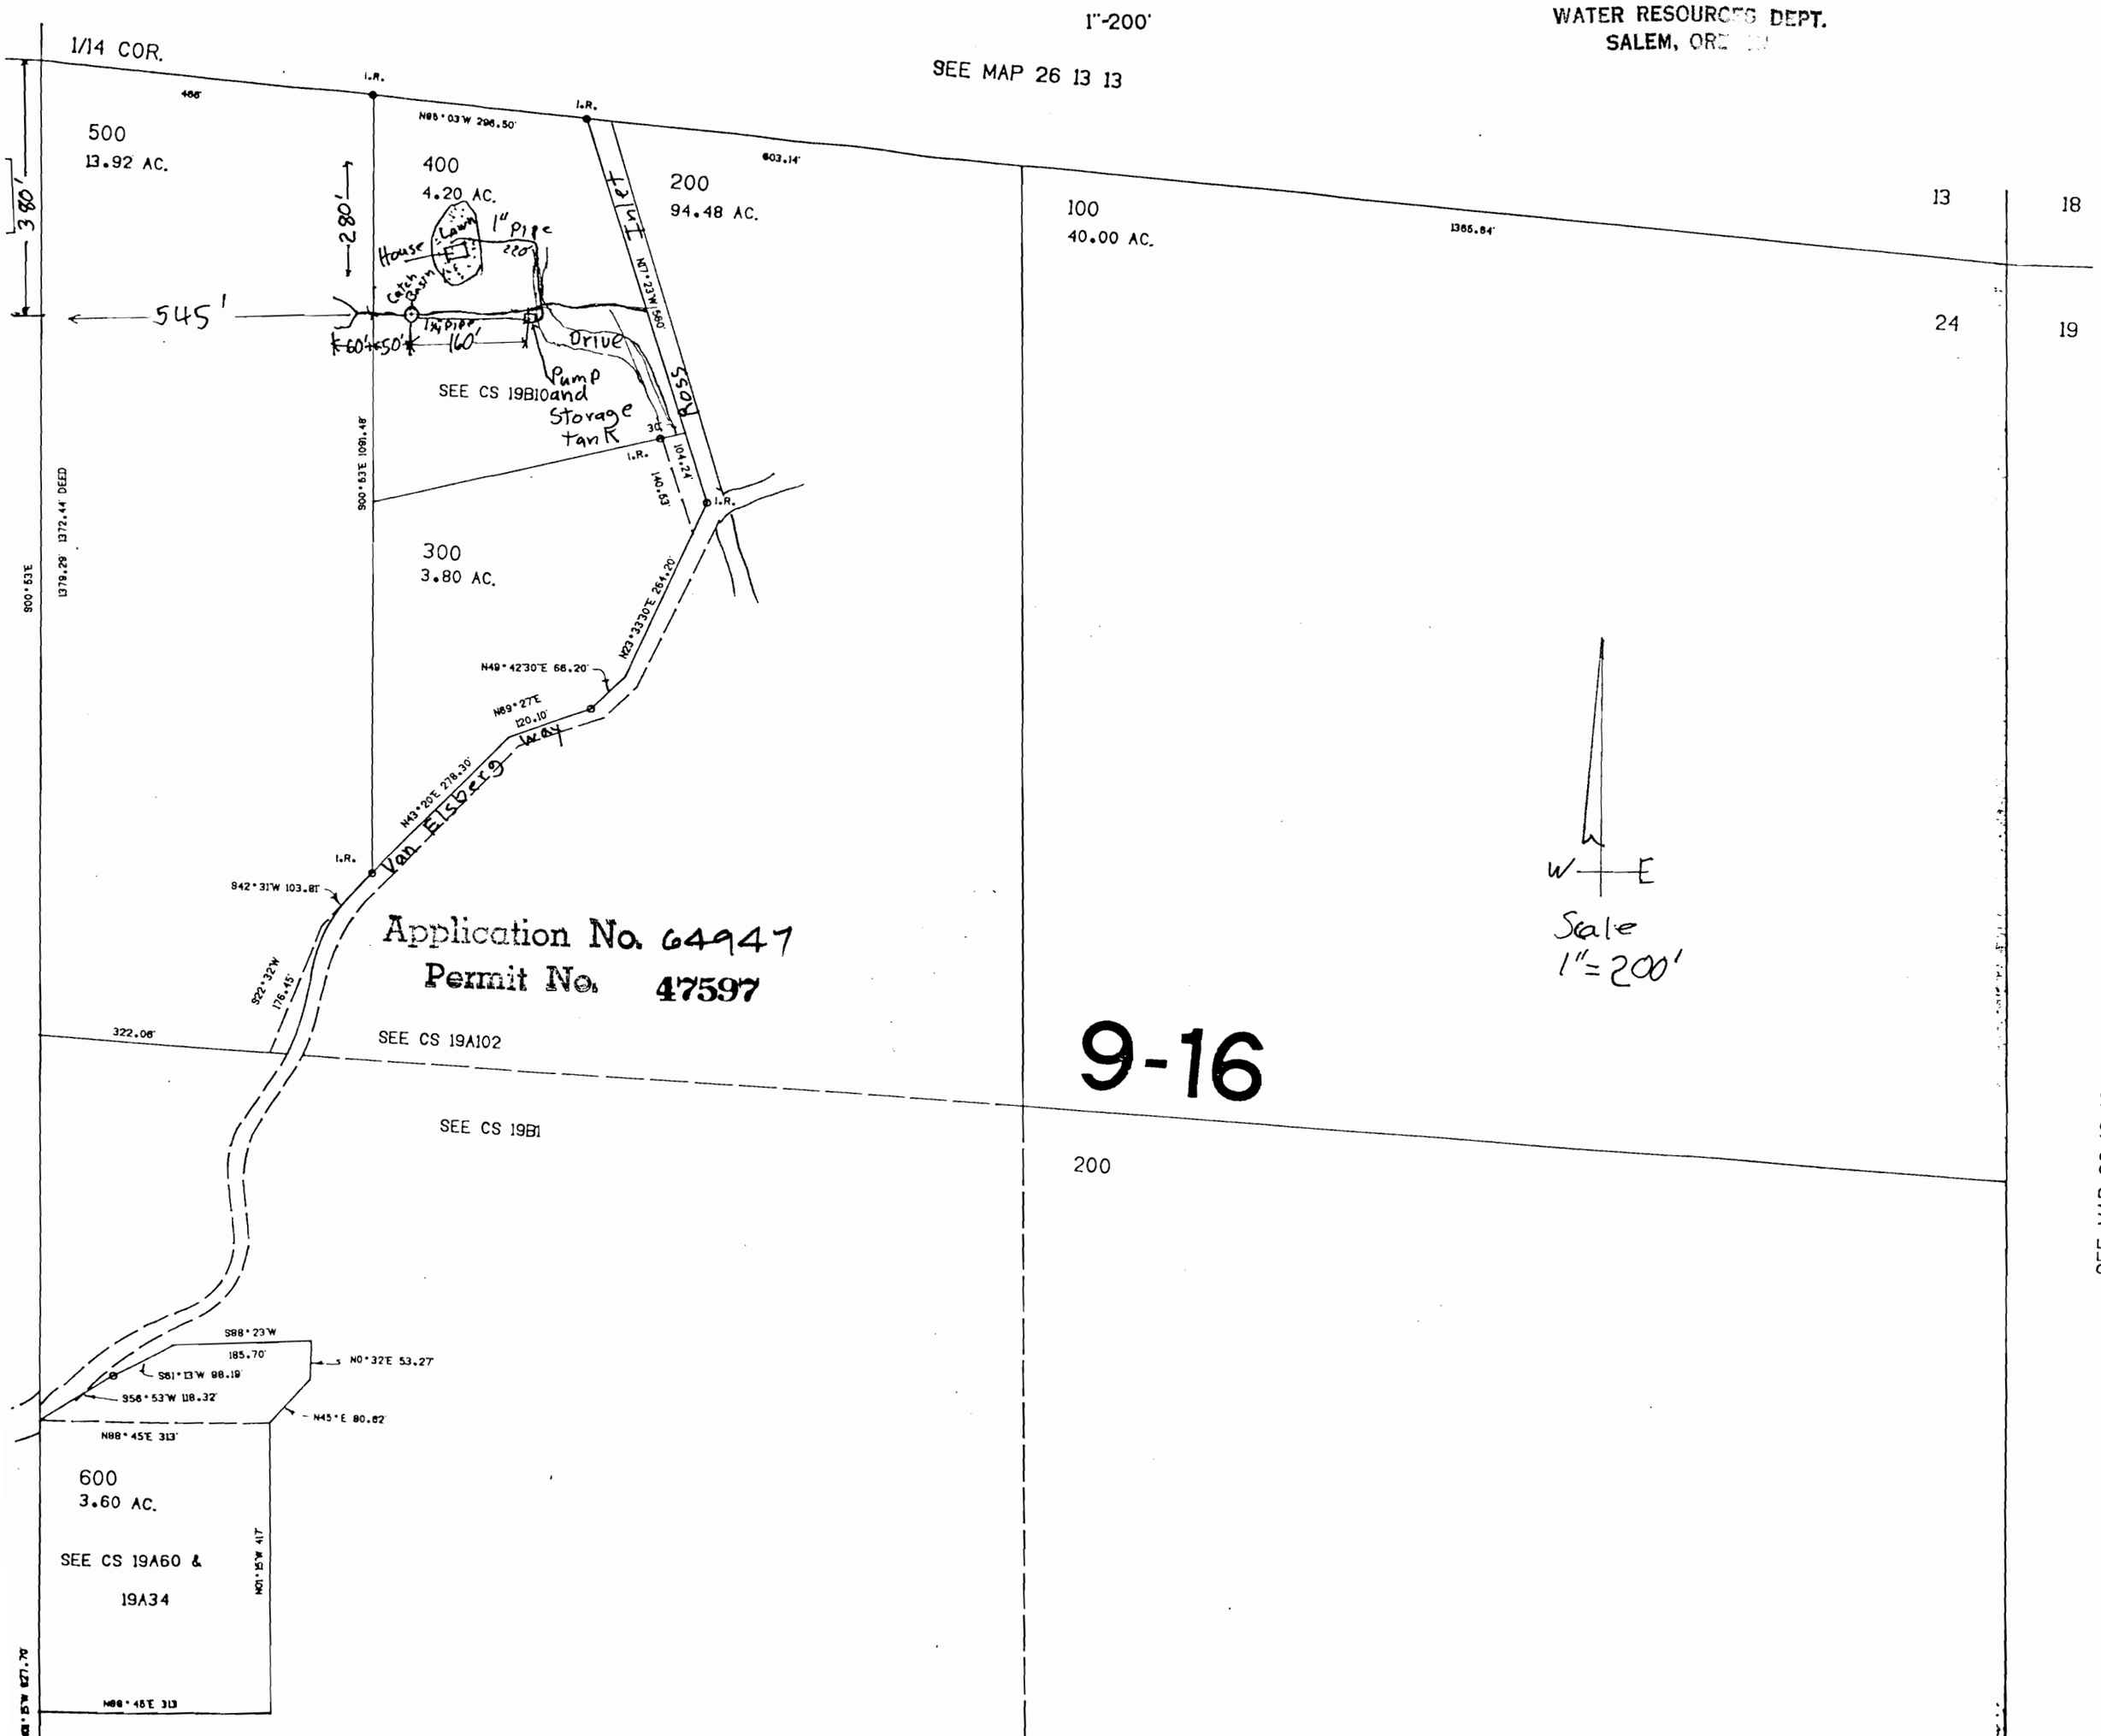
RECEIVED
MAY 17 1983
WATER RESOURCES DEPT.
SALEM, OREGON