


T. 40 S., R. 8 W., W. M.

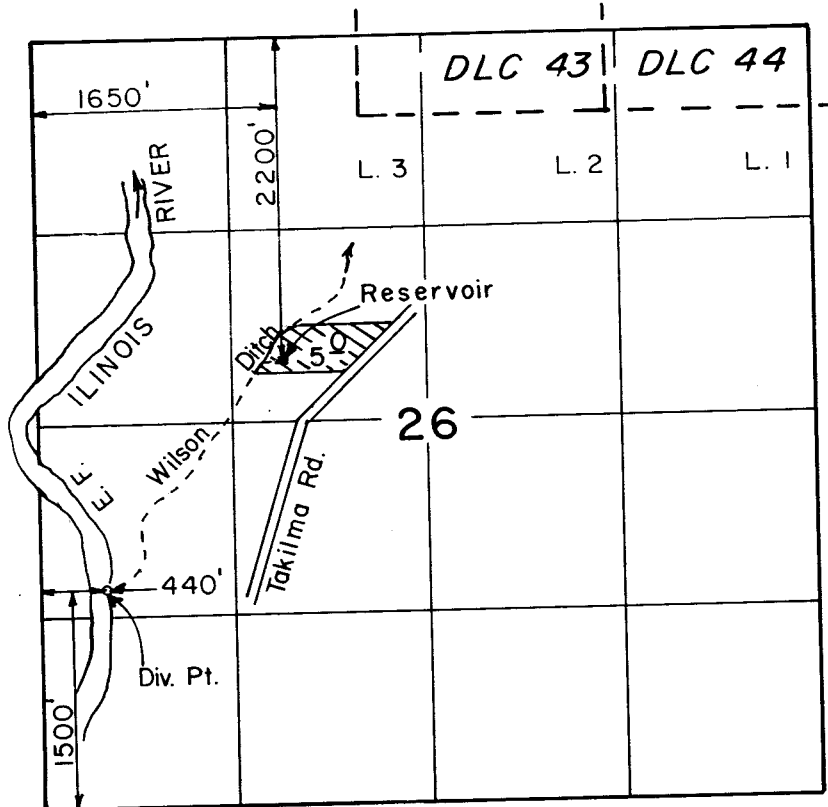

Scale: 1" = 1320'

### FINAL PROOF SURVEY UNDER

R-65185

R-8800

Application No. 64950. Permit No. 47598....

IN NAME OF

.....JAY.....K.....ZIEBA.....

Surveyed APR. 12. 1988, by B. S. JAMES.

4033-179-187A