


Sec. 22

Tp. 35

R. 40 E

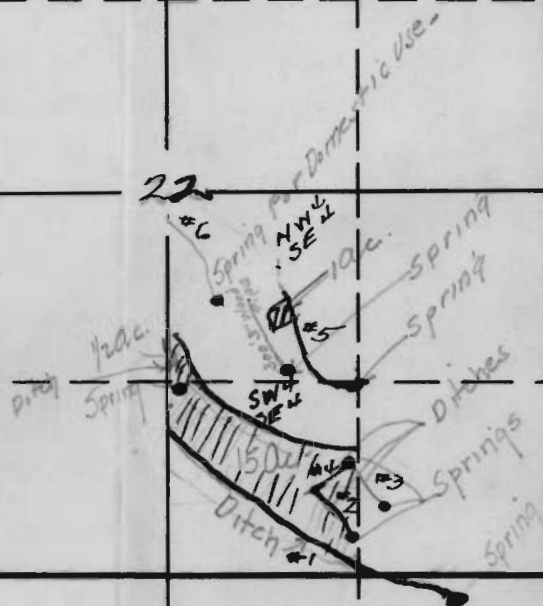

Application No. ~~7498~~
Hermit No. 4760

7498
~~7498~~
4760

OFFICE OF STATE ENGINEER

RECEIVED

AUG 25 1920


26

27