


47633
37-9-8

T. 37 S., R. 9 W., W. M.

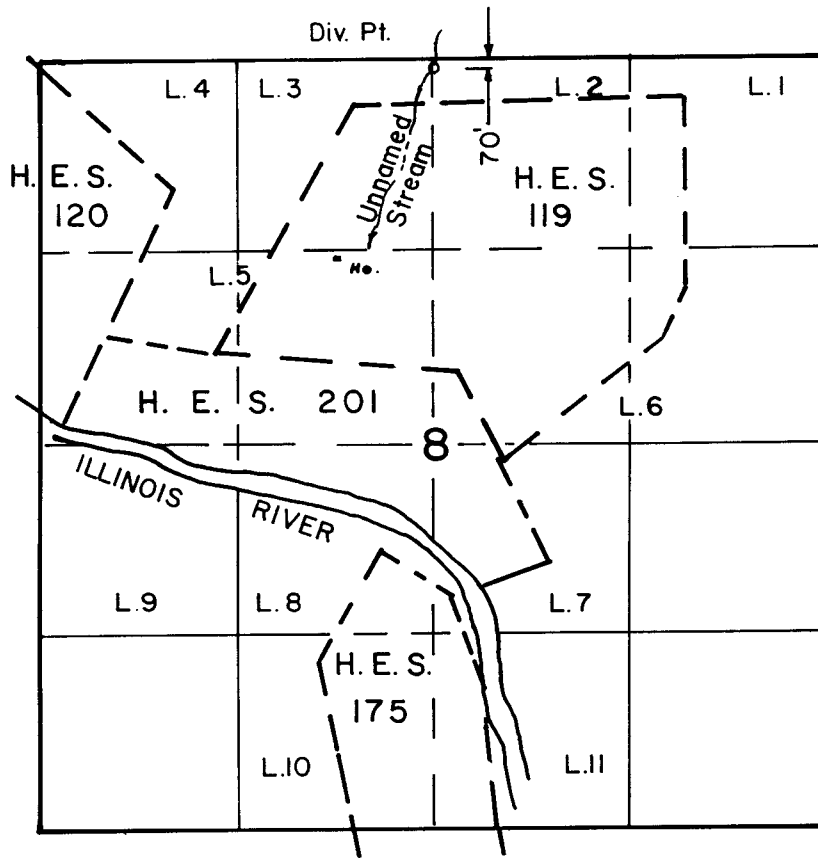

Scale: 1" = 1320'

FINAL PROOF SURVEY
UNDER

Application No. 64842 Permit No. 47633...
IN NAME OF

.....W. STEVEN..... WALLMANN.....

Surveyed JULY 10, 1991., by B. S. JAMES...

11033-179-15R

LMS 1/92