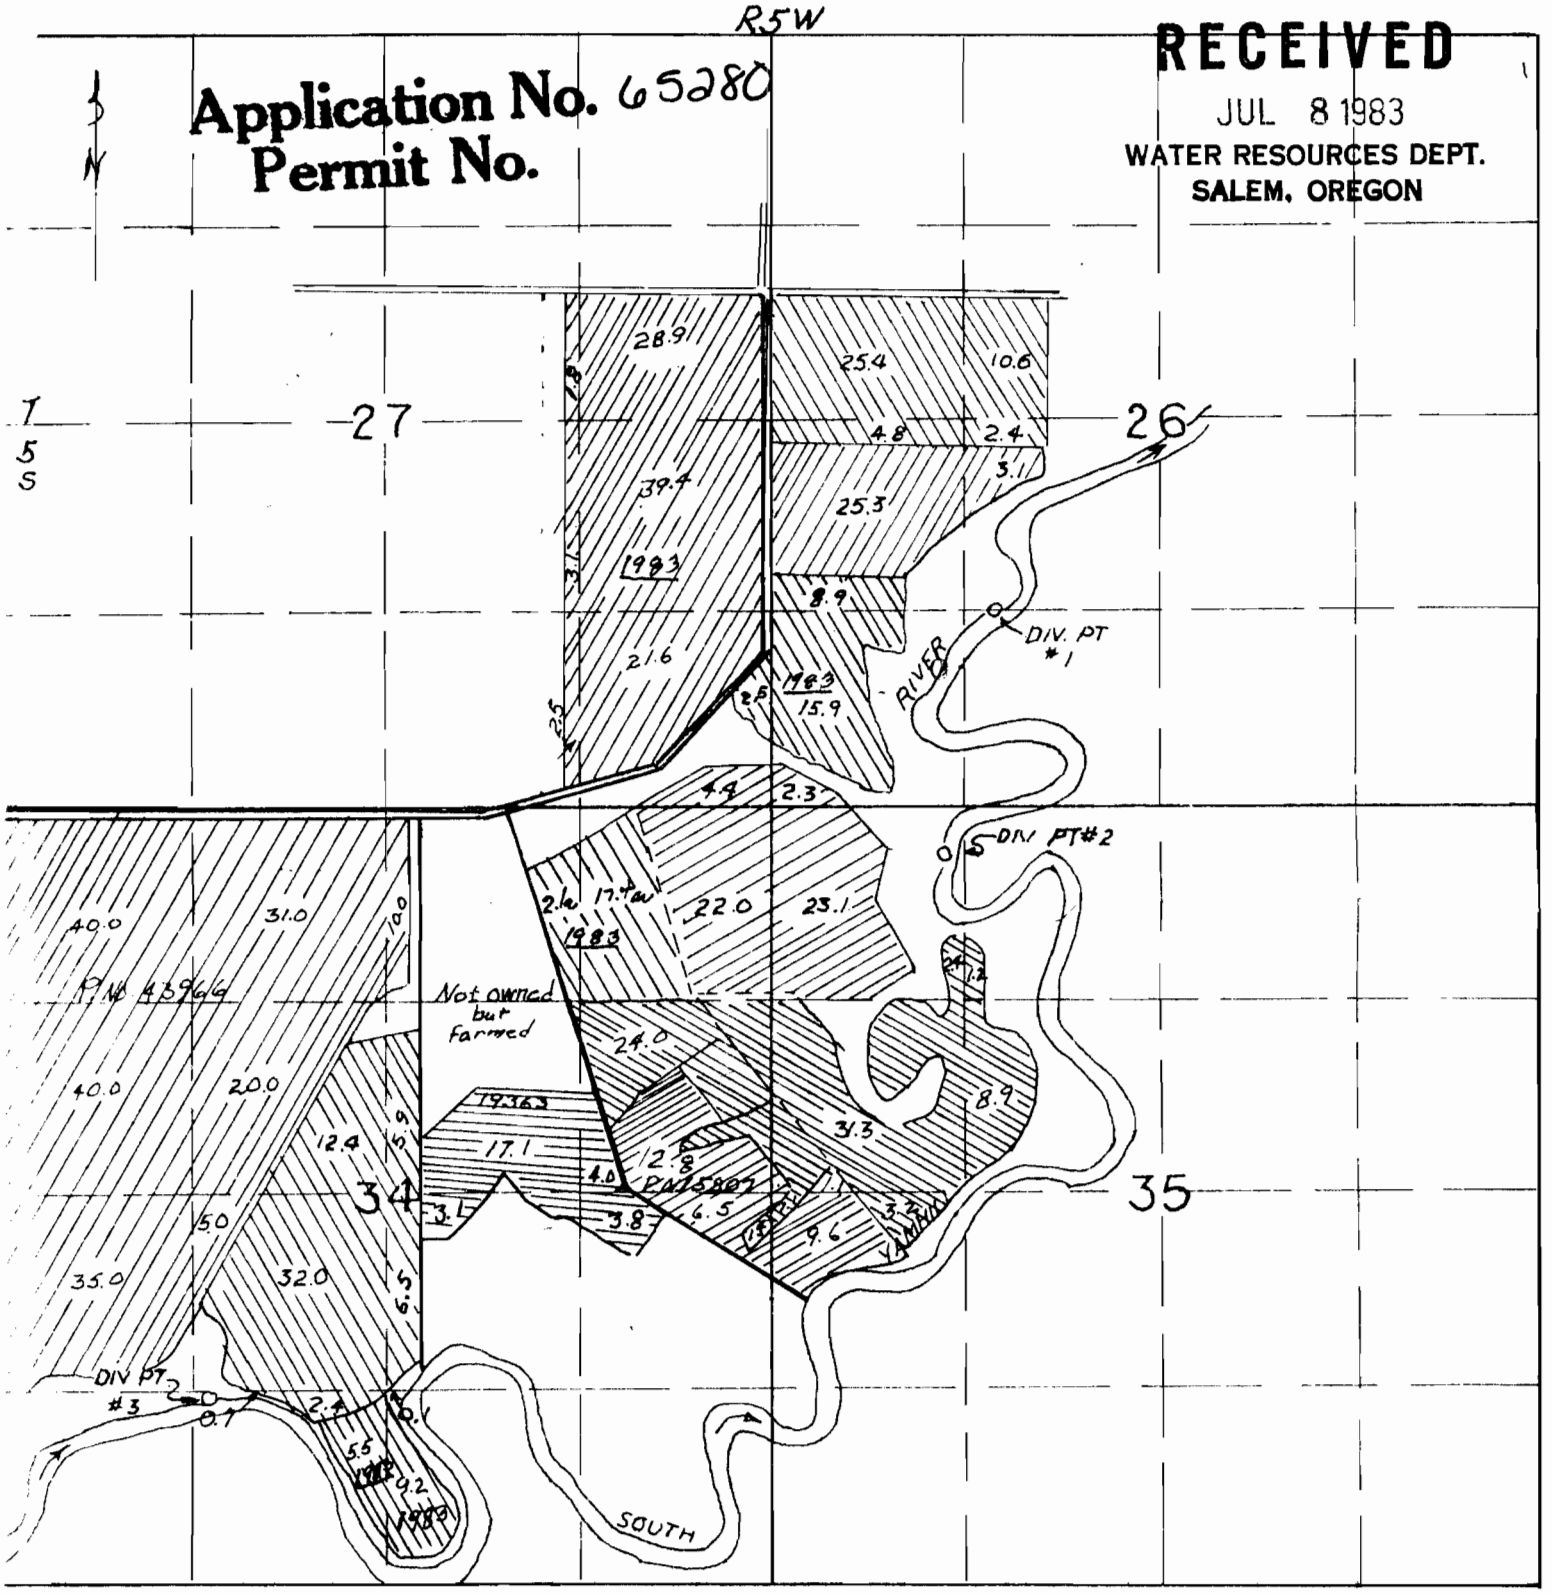

Location Map
Crimson West Farms, Inc.
Route 1 Box 256
Mc Minnville Ore 97128
Scale: 1 inch = 1320 ft.

T5S, R5W, W.M.
Yamhill County
Transfer Map - Certificate 64561
Christensen Farms LLC

RECEIVED
SEP 27 2012
WATER RESOURCES DEPT
SALEM, OREGON

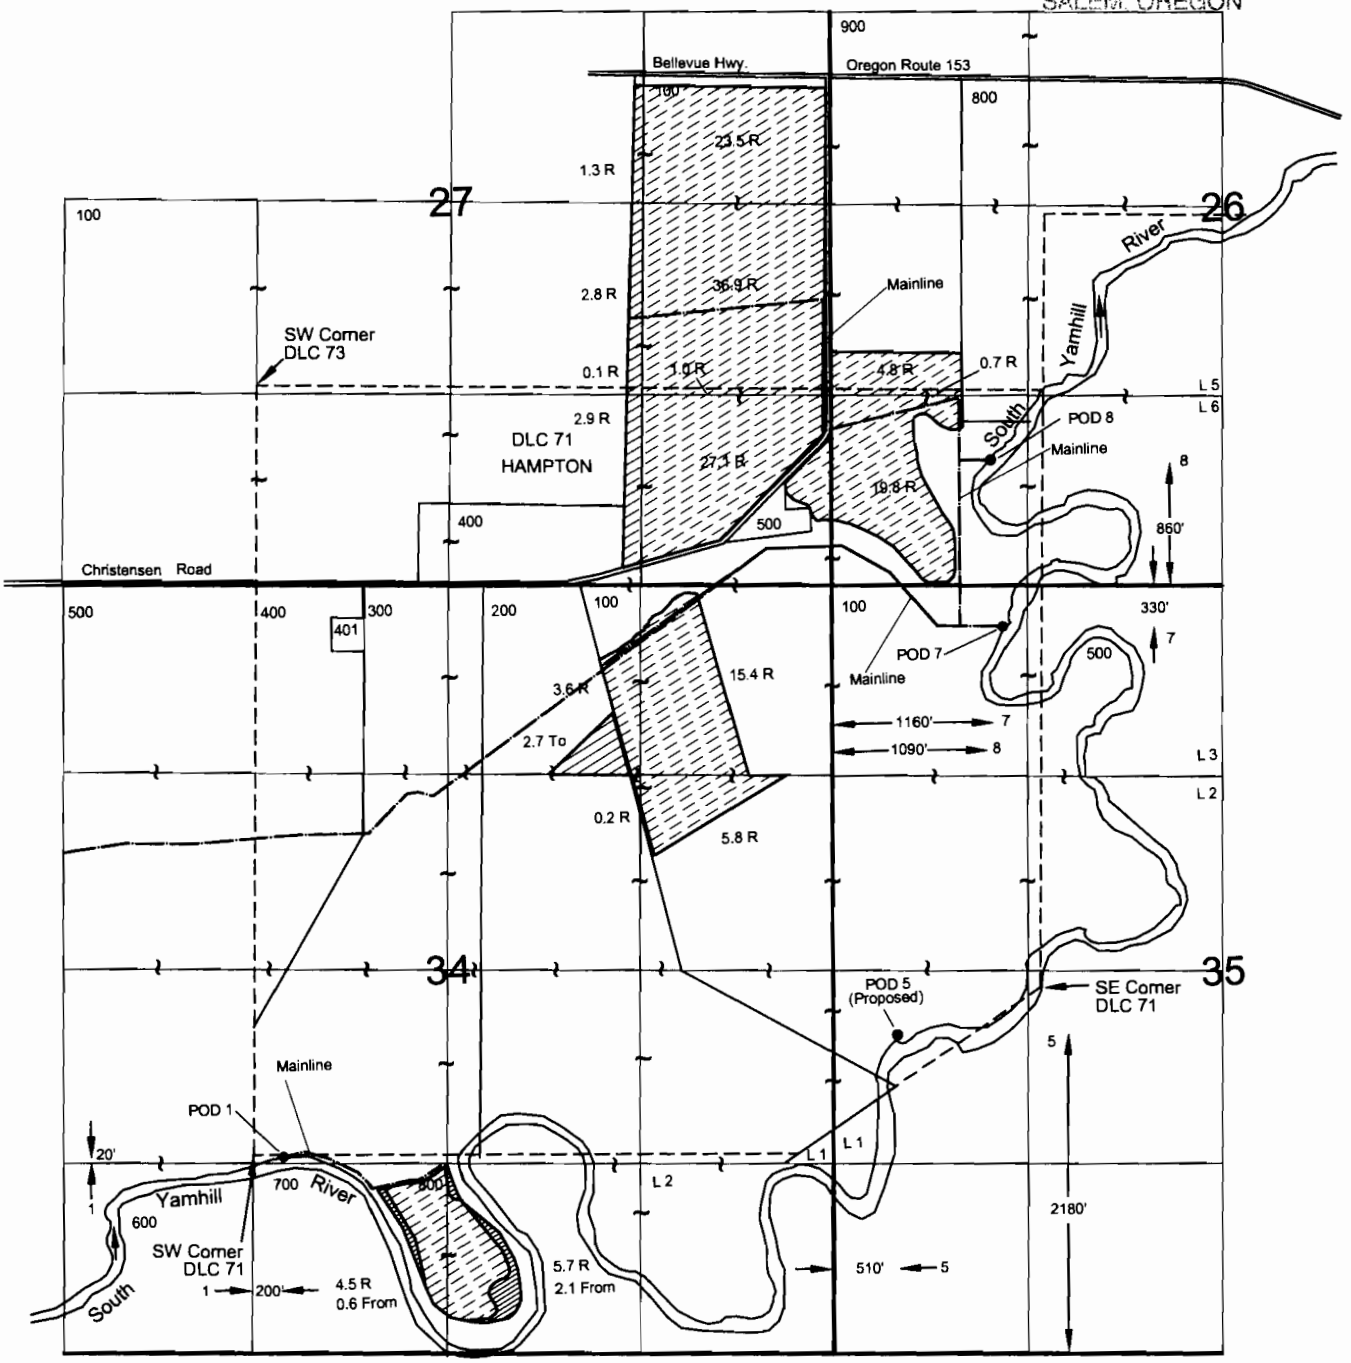

August 20, 2012

THIS MAP IS NOT INTENDED TO PROVIDE LEGAL DIMENSIONS OR LOCATIONS OF PROPERTY OWNERSHIP LINES.

SKOOKUM
WATER ASSOCIATES INC
P.O. Box 80174
Portland, OR 97280
(503) 319-8926

Certified Water Right Examiner
439 WRE
Steven R. Bruce
STEVEN R. BRUCE
JUNE 13, 1997
Expires 12/31/2013
STATE OF OREGON

North

0 660' 1320' 1980' 2640'

Scale: 1 inch = 1320 feet

Explanation:

Remaining Rights - 156.1 (R)

From Lands - 2.7 A (From)

To Lands - 2.7 A (To)

Priority Date: July 8, 1983

Figure 10