

Application No. 65305  
Permit No. 47687


RECEIVED  
JUL 15 1983  
WATER RESOURCES DEPT.  
SALEM, OREGON

T. 26S. R. 3W. S. 11

1" = 100'

NW Cor.  
SW<sup>1</sup>/<sub>4</sub> NE<sup>1</sup>/<sub>4</sub>  
S. 11

SW<sup>1</sup>/<sub>4</sub> NE<sup>1</sup>/<sub>4</sub>

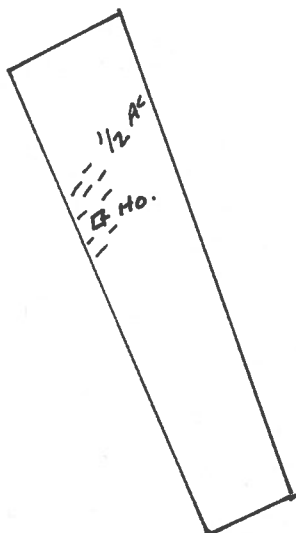

North  
Umpqua

\* P.O.D.  
960' S. & 320' E  
from NW Cor.  
SW<sup>1</sup>/<sub>4</sub> NE<sup>1</sup>/<sub>4</sub> S. 11

WATER RESOURCES DEPT.  
SALEM, OREGON

RECEIVED  
JUL 15 1983  
WATER RESOURCES DEPT.  
SALEM, OREGON