


T. 38 S., R. 6 W., W. M.

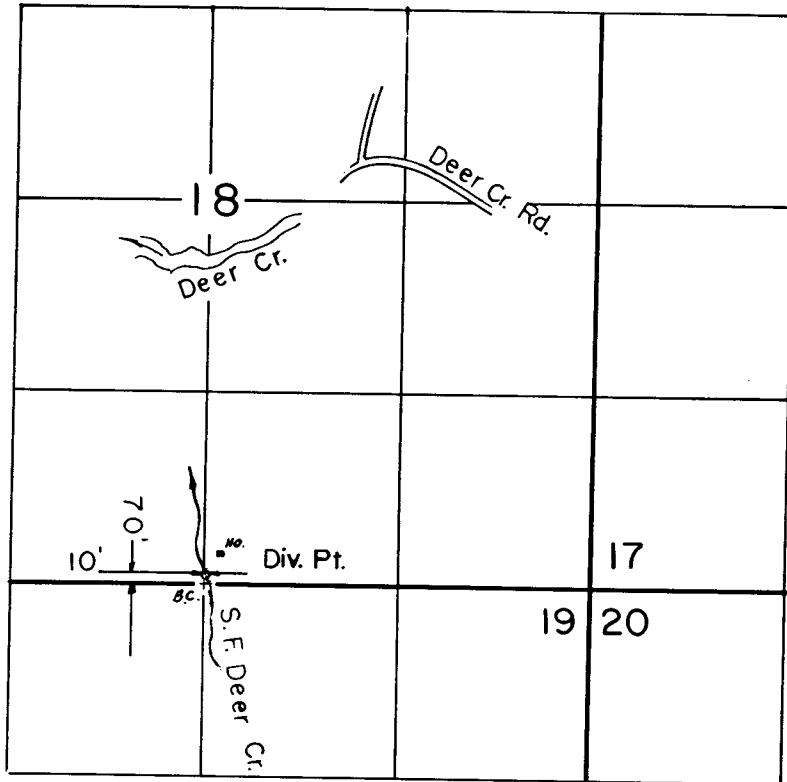

Scale: 1" = 1320'

FINAL PROOF SURVEY

UNDER

RECEIVED
APR 10 1991
WM. DIST. 14
GRANTS PASS, ORE.

Application No. 65313.. Permit No. 47692..
IN NAME OF

.....RODNEY G. GOLDEN.....

Surveyed MAY 19 1988, by B. S. JAMES...