


R16E



Application No. 64921  
Permit No. 47716

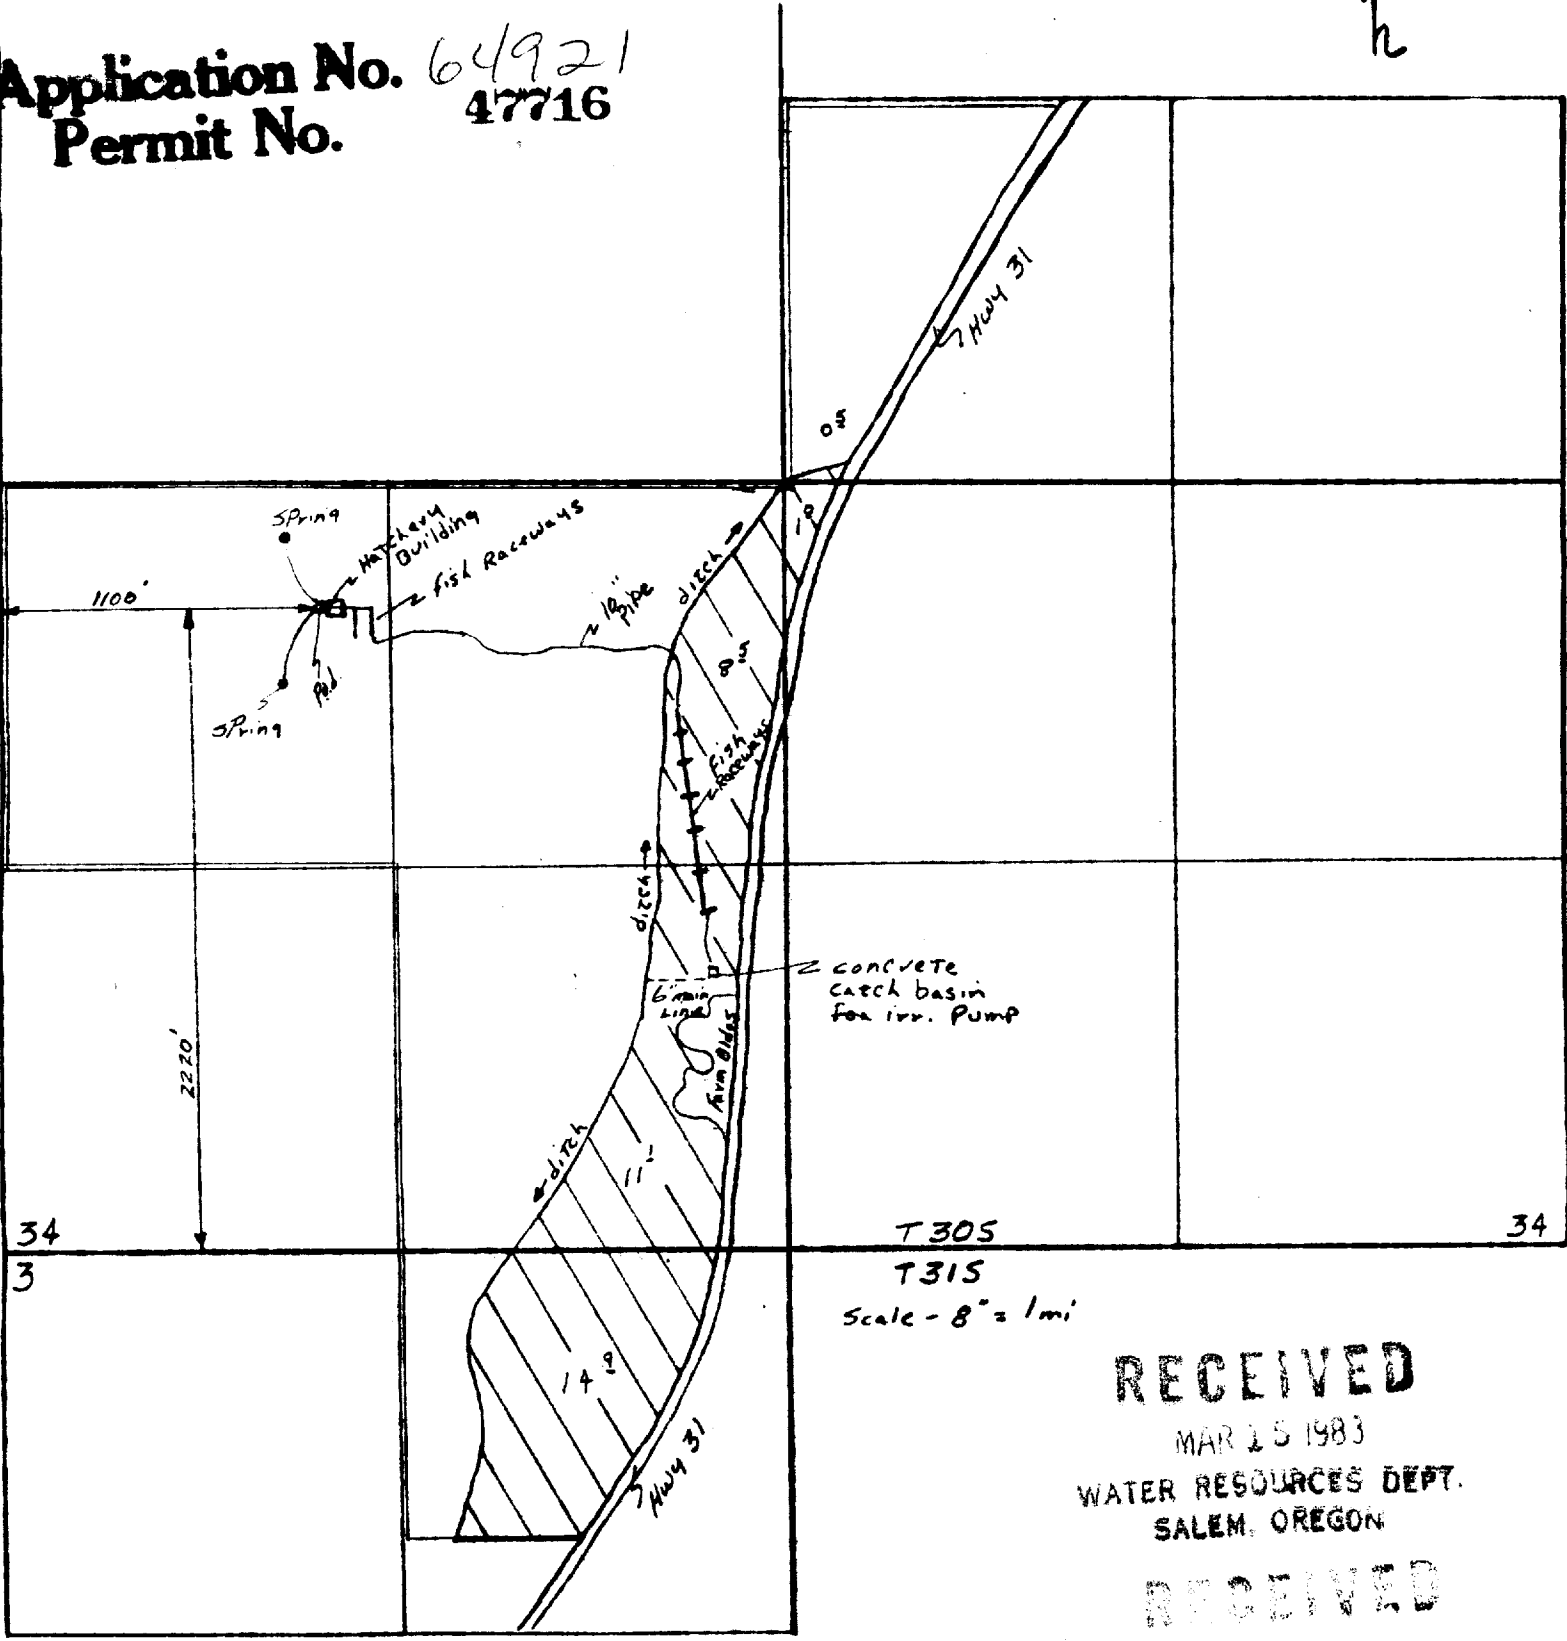

34  
3

34

T305  
T315  
Scale - 8" = 1 mi

**RECEIVED**  
MAR 25 1983  
WATER RESOURCES DEPT.  
SALEM, OREGON

**RECEIVED**  
JUN 3 1983  
WATER RESOURCES DEPT.  
SALEM, OREGON

All information on this map furnished by applicant  
Robert A. Olson  
Applicant