


Permit: S 47731  
Volume: 8A  
Strm: ELK CR  
Trib: W FK ILLINOIS R  
Priority: 5/27/83

T. 41 S., R. 9 W., W. M.

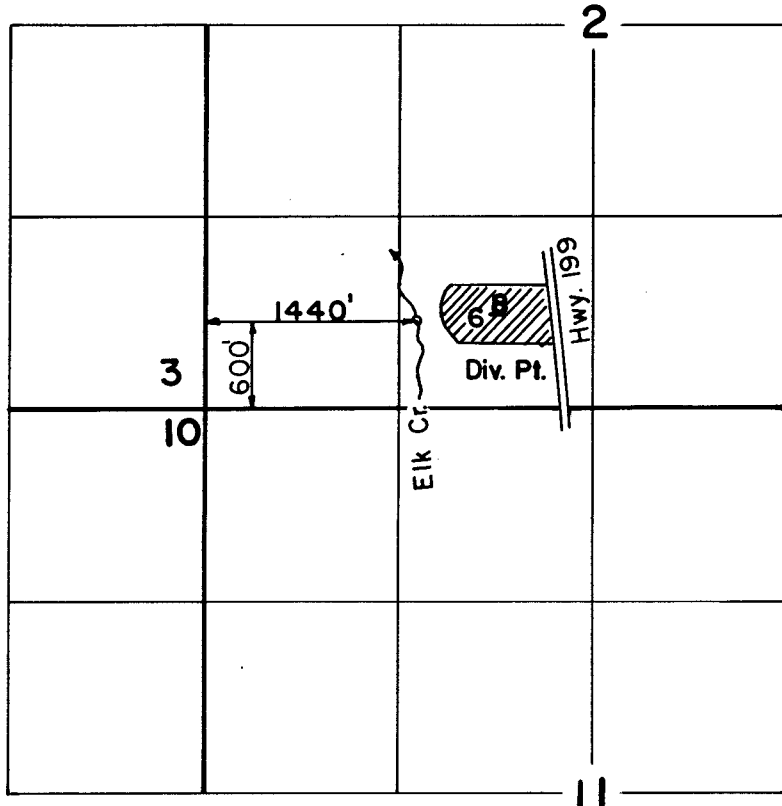

TL 1407

Scale: 1" = 1320'

**FINAL PROOF SURVEY**  
UNDER

W.D. DIST. 14  
GRANTS PASS, ORE.

Application No. 65156. Permit No. 47731...  
IN NAME OF  
GORDON & JEAN ROBERTSON  
Surveyed APR. 13. 1988., by B.S. JAMES...

4132-179-2434  
7/91  
LMS