


Permit: S 47735
Volume: 5
Strm: JACK CR
Trib: JUMPOFF JOE CR
Priority: 8/03/83

T. 34S., R. 5W.,

MAY 20 1985

BYM DIST. 14
GRANTS PASS, OR

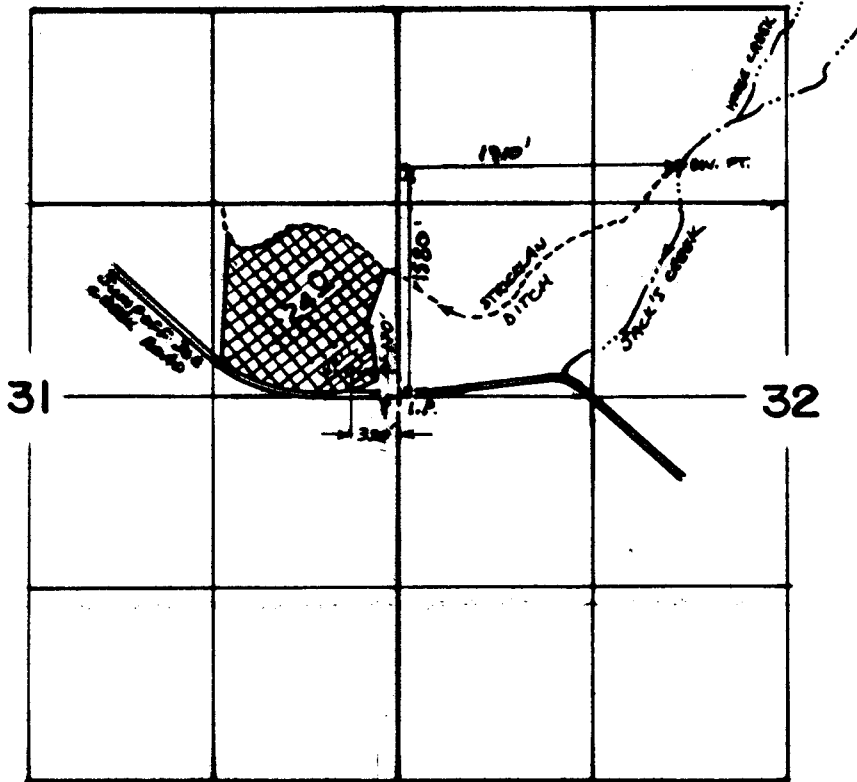

SCALE: 4" = 1 MILE

 JACK'S CREEK

 WELL

FINAL PROOF SURVEY
UNDER

G-10580 G-9778
Application No. ~~65502~~ Permit No. ~~47735~~...
IN NAME OF

RICHARD D. STRICKLAN

Surveyed JULY 12, 1984, by B. S. JAMES

41083-119-132A JRW