


Permit: S 47765
Volume: 6B
Strm: RESERVOIR
Trib: WILLIAMS CR
Priority: 7/05/83

T. 38 S., R. 5 W., W. M.

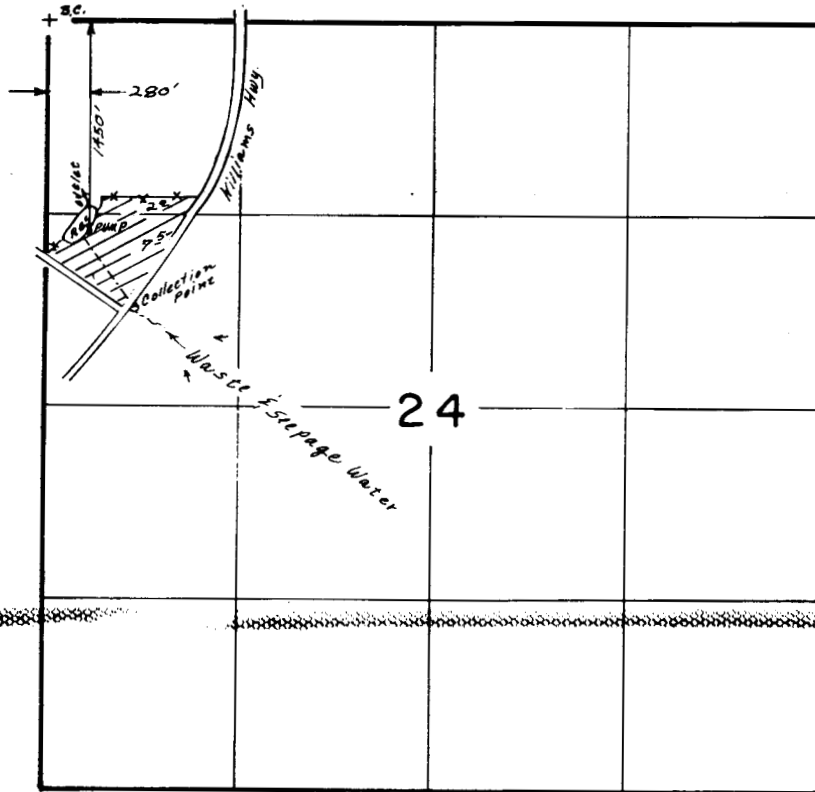

Scale: 1" = 1320'

RECEIVED

MAY 6 1991

WM. DIST. 14
GRANTS PASS, ORE

FINAL PROOF SURVEY

UNDER

R-65266 R-8837
Application No. 64167 Permit No. 47765
IN NAME OF

JAMES C. & EDITH L. KEDING

Surveyed AUG...8... 19.88, by B...S...JAMES....