


Permit: S 47770
Volume: 8
Strm: E FK ILLINOIS R
Trib: ILLINOIS R
Priority: 8/02/83

T. 39 S., R. 8 W., W. M.

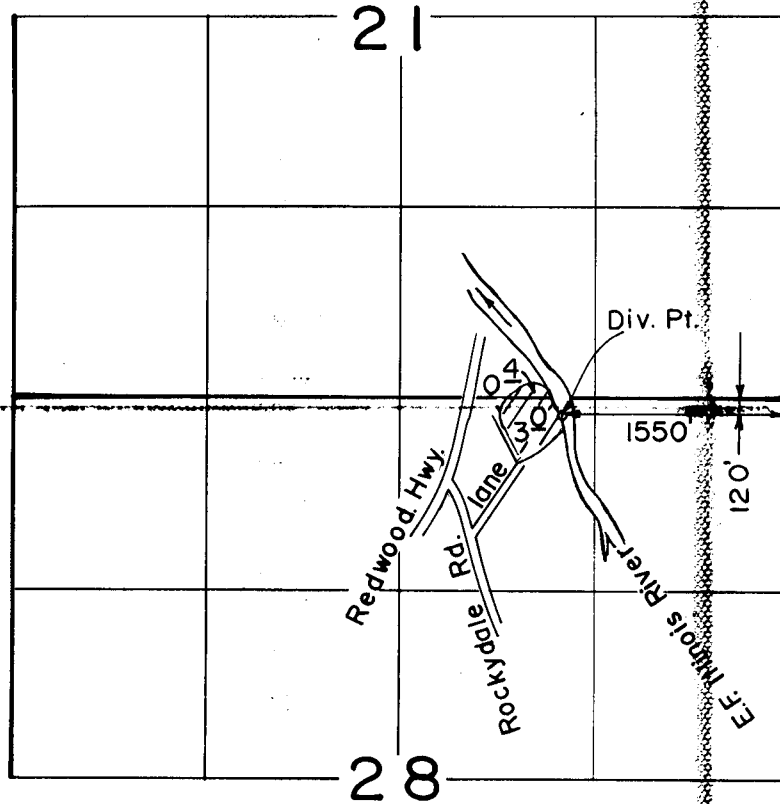

Scale: 1" = 1320'

RECEIVED

MAY 20 1991

WM. DIST. 14
GRANTS PASS, ORE.

FINAL PROOF SURVEY UNDER

Application No. 65496 Permit No. 47770
IN NAME OF

GEORGE E. & MARIAN M. CASBIER

Surveyed APR. 14. 1988, by B. S. JAMES.