


T. 37 S., R. 6 W., W. M.

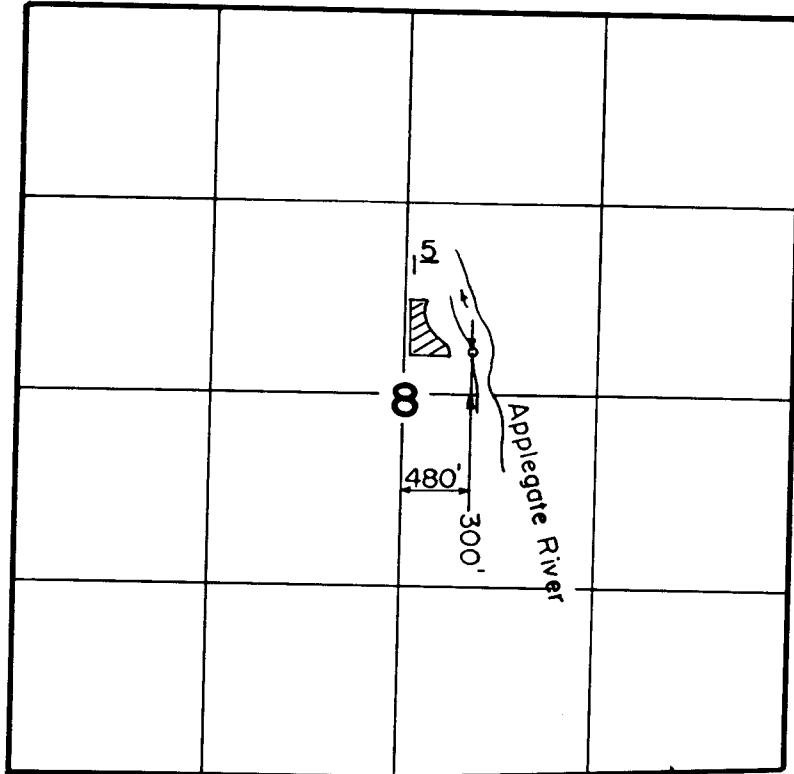

Scale: 1" = 1320'

RECEIVED

APR 24 1991

WM. DIST. 14  
GRANTS PASS, ORE.

**FINAL PROOF SURVEY**  
UNDER

Application No. 65067 Permit No. 47802...  
IN NAME OF

.....RUSSELL E. BURCH.....

Surveyed AUG. 29. 1988, by B. S. JAMES...

850-2-9

L.M.J.  
3/11/91