


T 34S., R. 6 W., W.M.

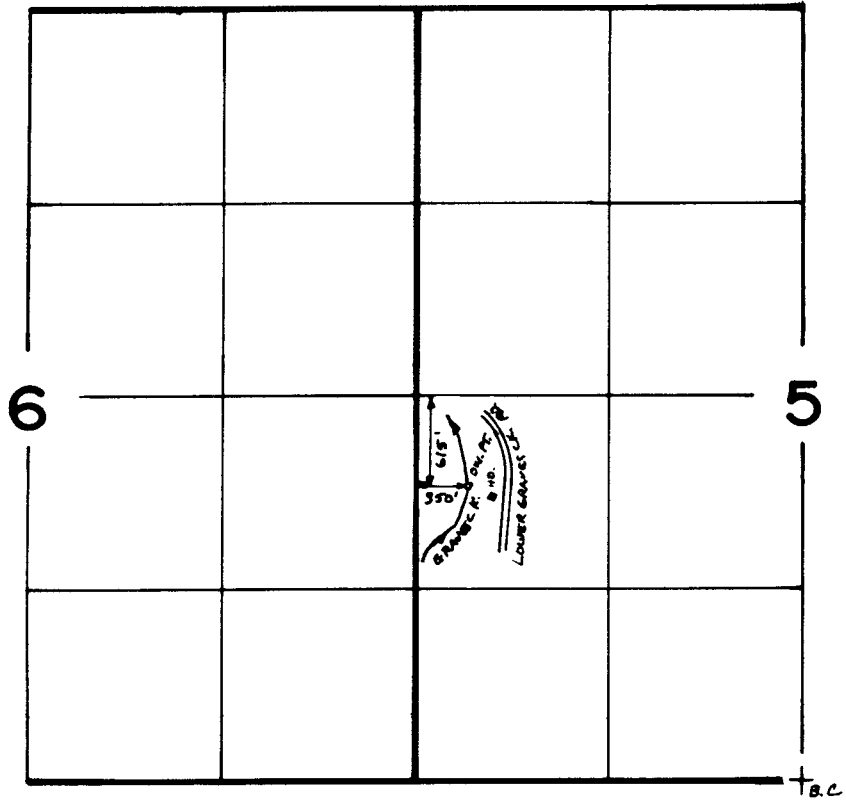

SCALE: 1"=1320'

FINAL PROOF SURVEY
UNDER

Application No. 65105 Permit No. 47819
IN NAME OF

KENNITH S. RUSSELL

Surveyed SEPT. 6 1984, by J.R. WOODRUFF.