


T. 3S., R. 40E., W.M.

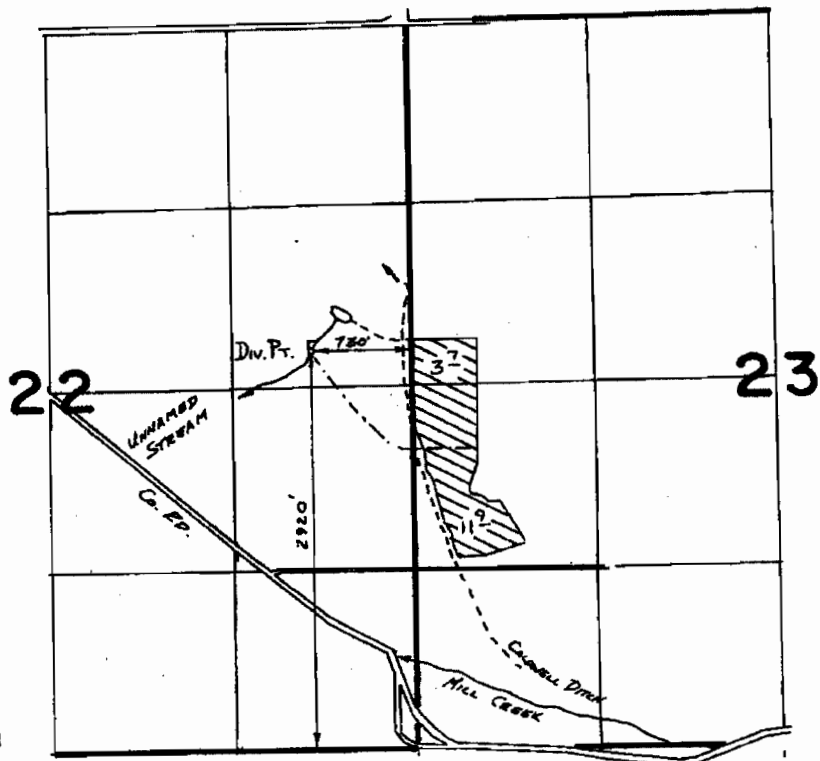

SCALE 1" = 1320'

FINAL PROOF SURVEY UNDER

Application No. **65157**... Permit No. **47834**..
IN NAME OF

REUBEN S. TESKE

Surveyed **4-7**..... **1987**., by **V.H. Church**.....