


T. 34 S., R. 5 W., W. M.

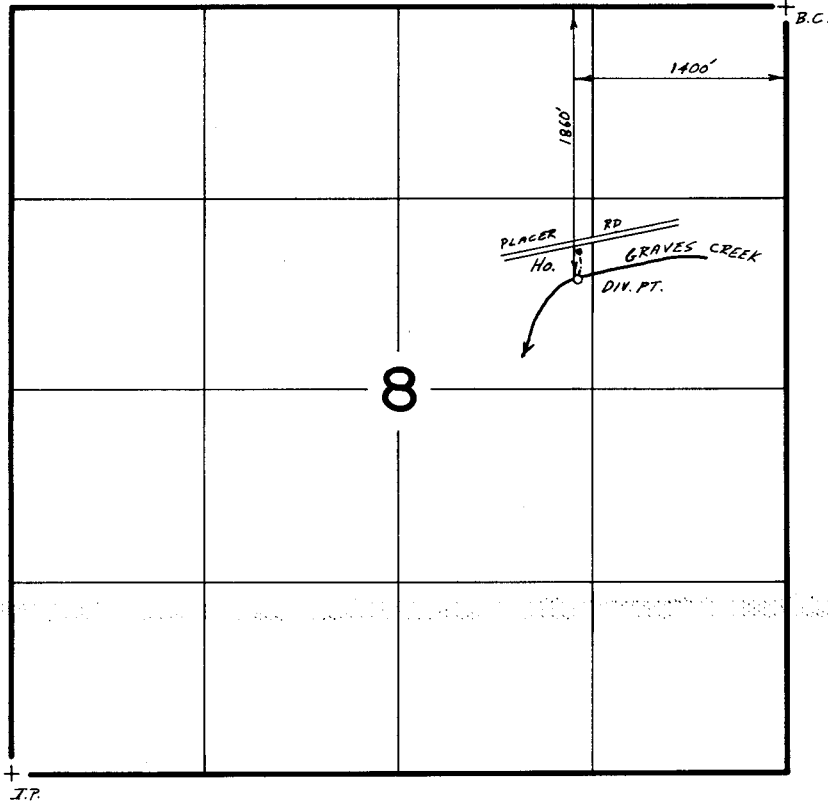

Scale 1"=1320'

RECEIVED  
JUL 14 1988

WM. DIST. 14  

**FINAL PROOF SURVEY**  
UNDER

Application No. 65165... Permit No. 47835...  
IN NAME OF

.....RICHARD D. PANKEY.....

Surveyed Aug. 13, 1986, by B.S. JAMES.....