Application No. 66058 & R-65269
Permit No.

R 8895 47906

RECEIVED
SEP 14 1983
WATER RESOURCES DEPT.
SALEM, OREGON

T29S R14W

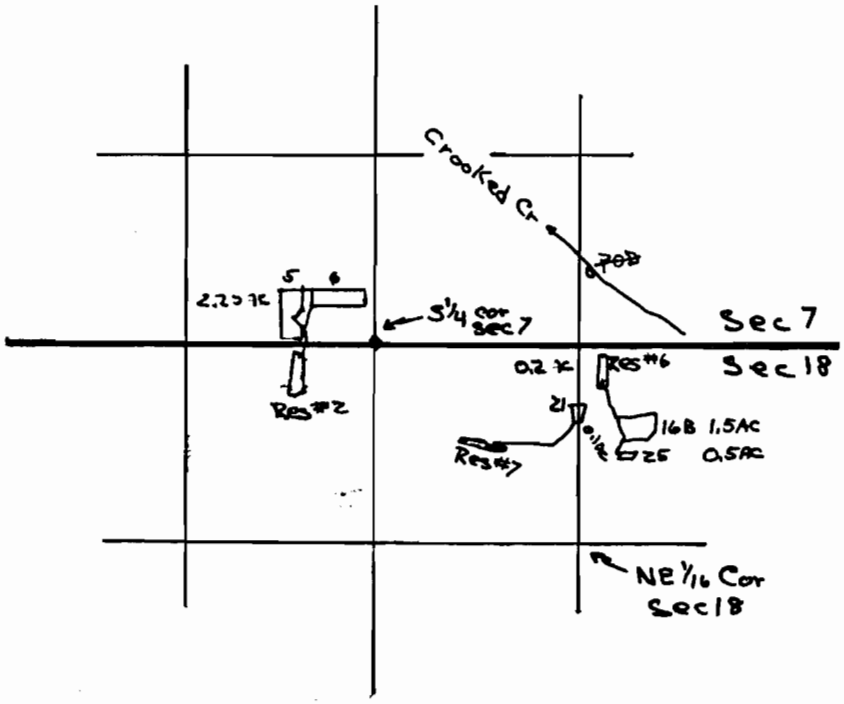


POD's

~~Crooked Cr 1707'N 26'E~~ from NE 1/16 cor Sec 18

| | | | |
|---|---|---|---|
| Res #2 | 1166'N 1856'W | " | " |
| Res #6 | 922'N 140'E | " | " |
| Res #7 | 656'N 563'E | " | " |

MAP PREPARED BY: J.P. Drolet, Coquille Field Office
INFORMATION FURNISHED BY THE