


33-6-24

4-901

T. 33 S., R. 5 & 6 W., W. M.

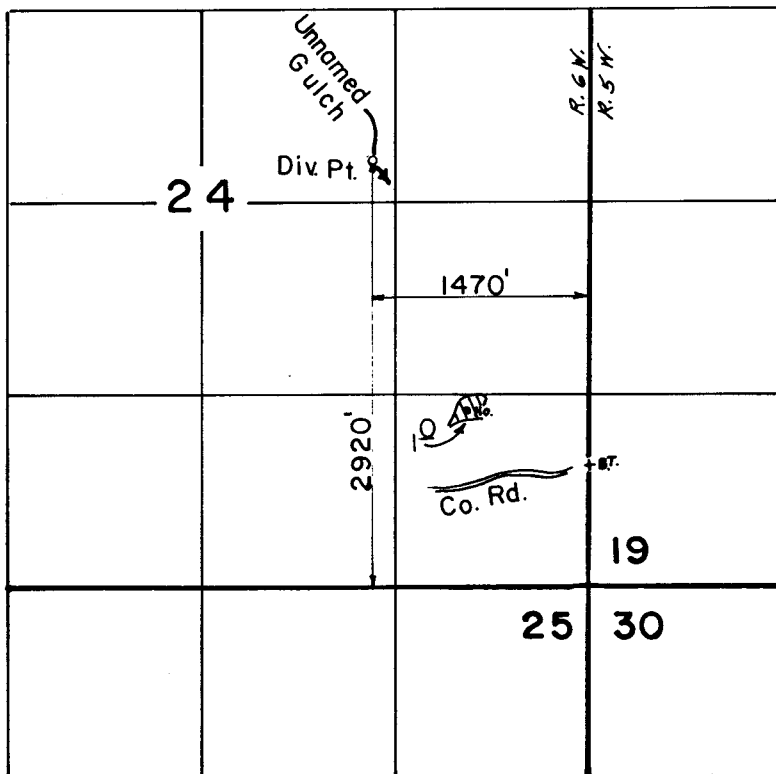

Scale: 1" = 1320'

FINAL PROOF SURVEY UNDER

Application No. 65479 Permit No. 47961....
IN NAME OF

JERRY.....L.....KILLINGSWORTH..

Surveyed MAY...3.. 1989, by B....S....JAMES.

4033-179-129R
12/91 LMS