


Permit: S 47962  
Volume: 5  
Strm: LOUSE CR  
Trib: JUMPOFF JOE CR  
Priority: 7/29/83



# T. 35 S., R. 5 & 6 W., W.M.

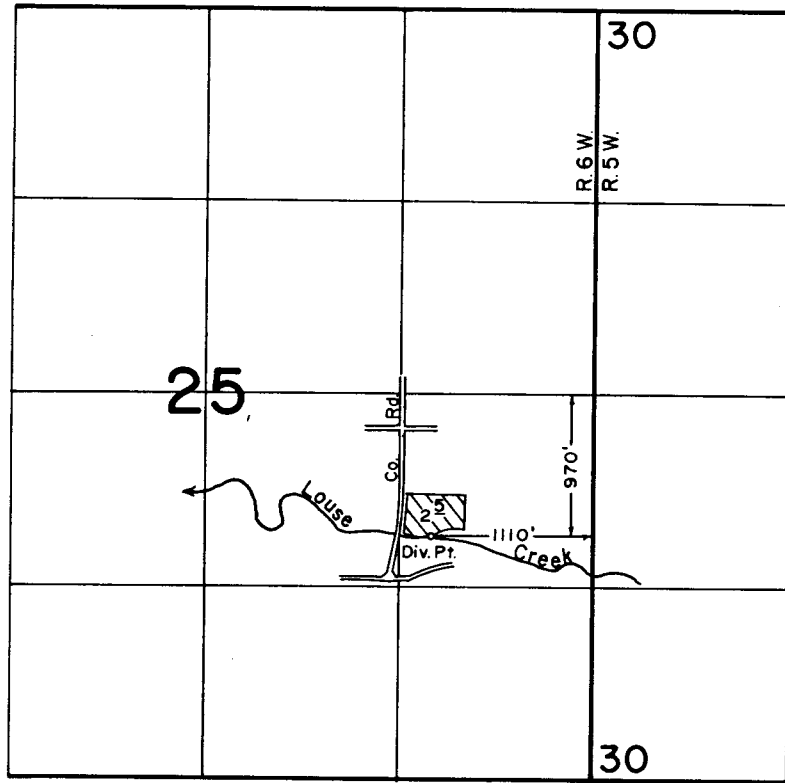

SCALE: 1" = 1320'

## FINAL PROOF SURVEY UNDER

Application No. 65480... Permit No. 47962.....  
IN NAME OF

**THOMAS J. & SHIRLEY A. COSAERT**

Surveyed MAY 15... 1989, by B. S. JAMES.....

RECEIVED

MAR 28 1991

WM. DIST. 14  
GRANTS PASS, ORE.

11-27-89  
41033-179-135 L