


SW $\frac{1}{4}$ NE $\frac{1}{4}$ Section 27

T. 26 S. R. 6 W. W.M.

Application No. 65482

Permit No. 47963

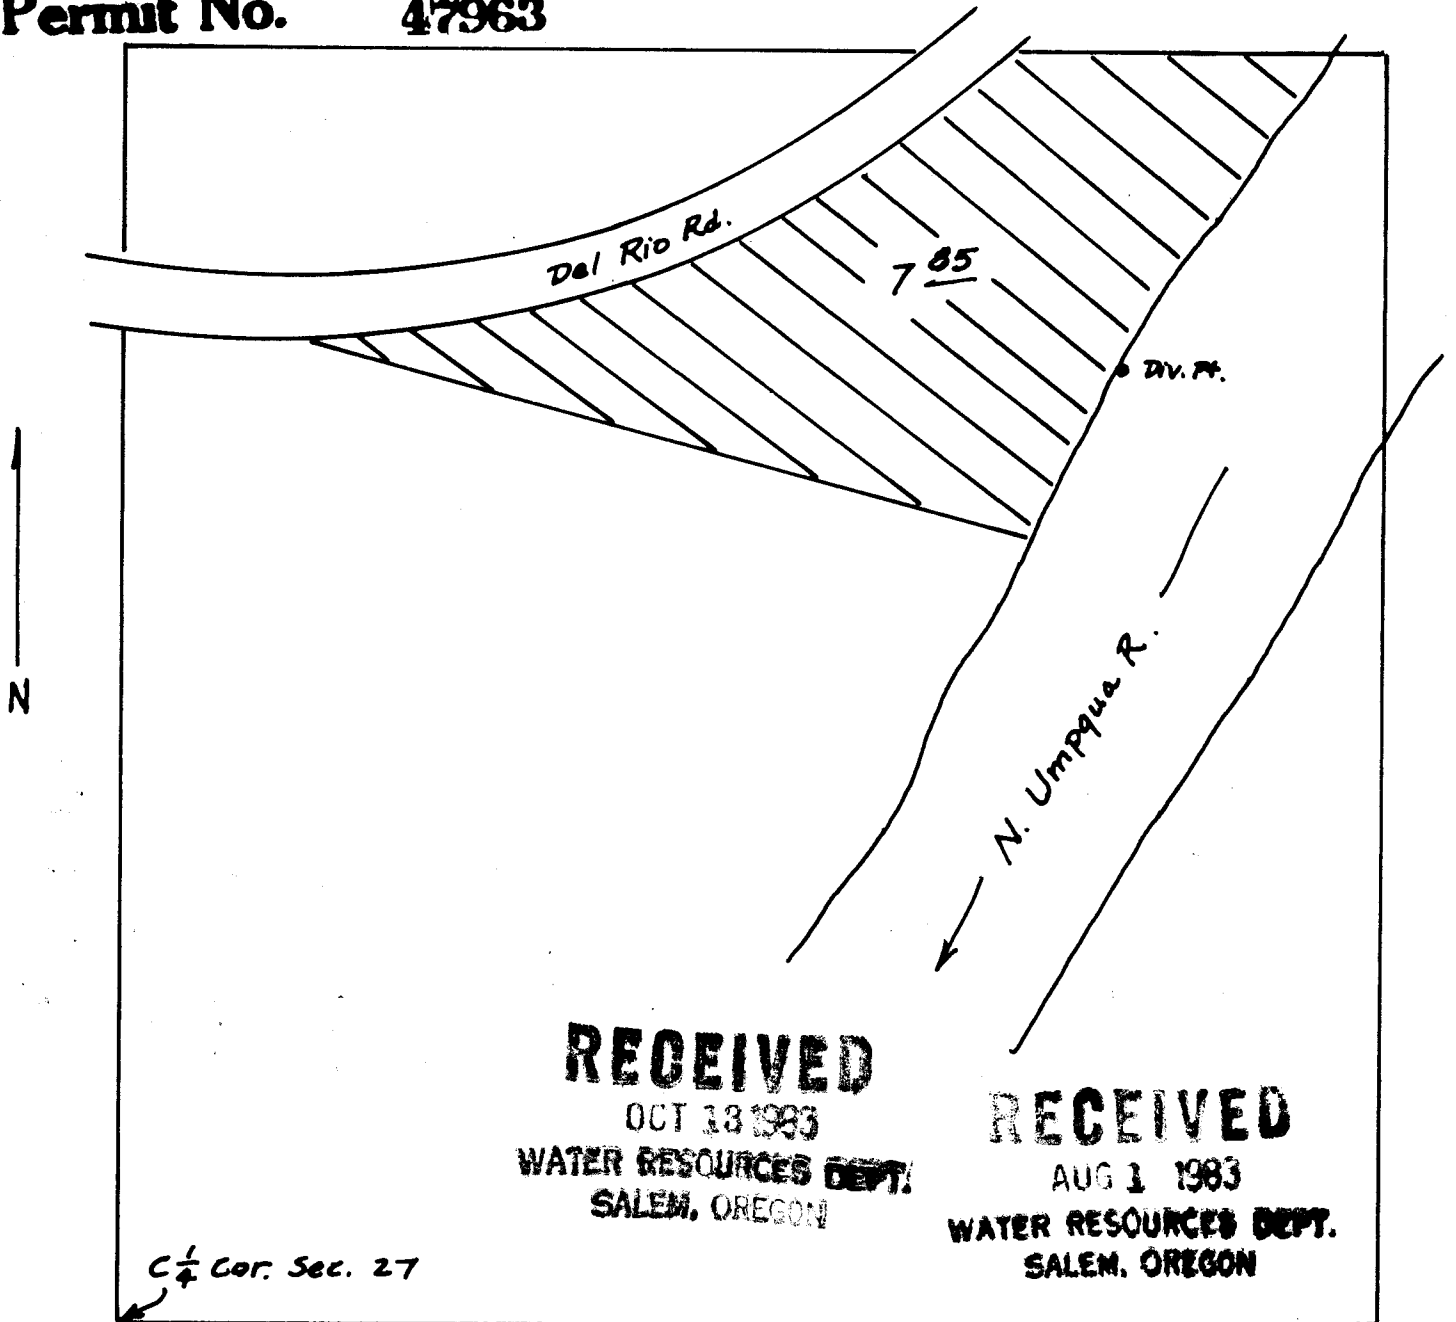

Scale: 1" = 200'

Div. Pt. : 1000' N. and 1040' E from the center of Sec. 27.