


App. No. 7568  
Plan No. 4810

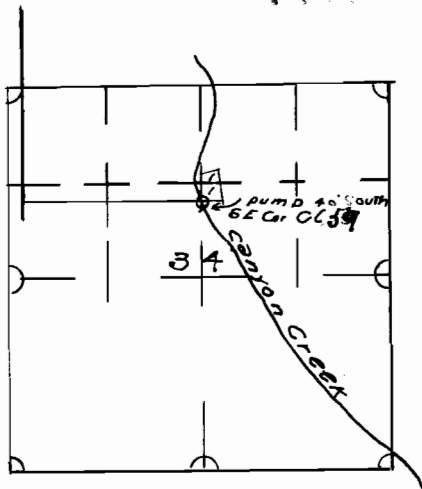

SCALE  
40 CHS TO 1"

SULLIVAN PUMPING PLANT  
IN  
SEC. 34, TP 30 S., R 5 W., W.M.  
DOUGLAS COUNTY OREGON.