


RECEIVED

OCT 6 1983


T. 26 S. R. 6 W. S. 19

**WATER RESOURCES DEPT.
SALEM, OREGON**

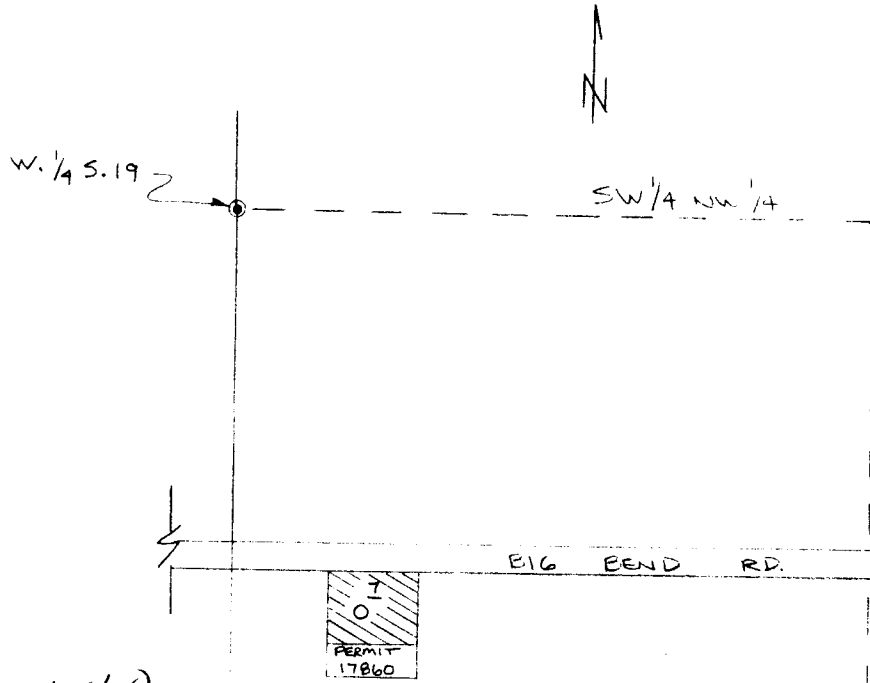

67360

**Application No.
Permit No. 48163**

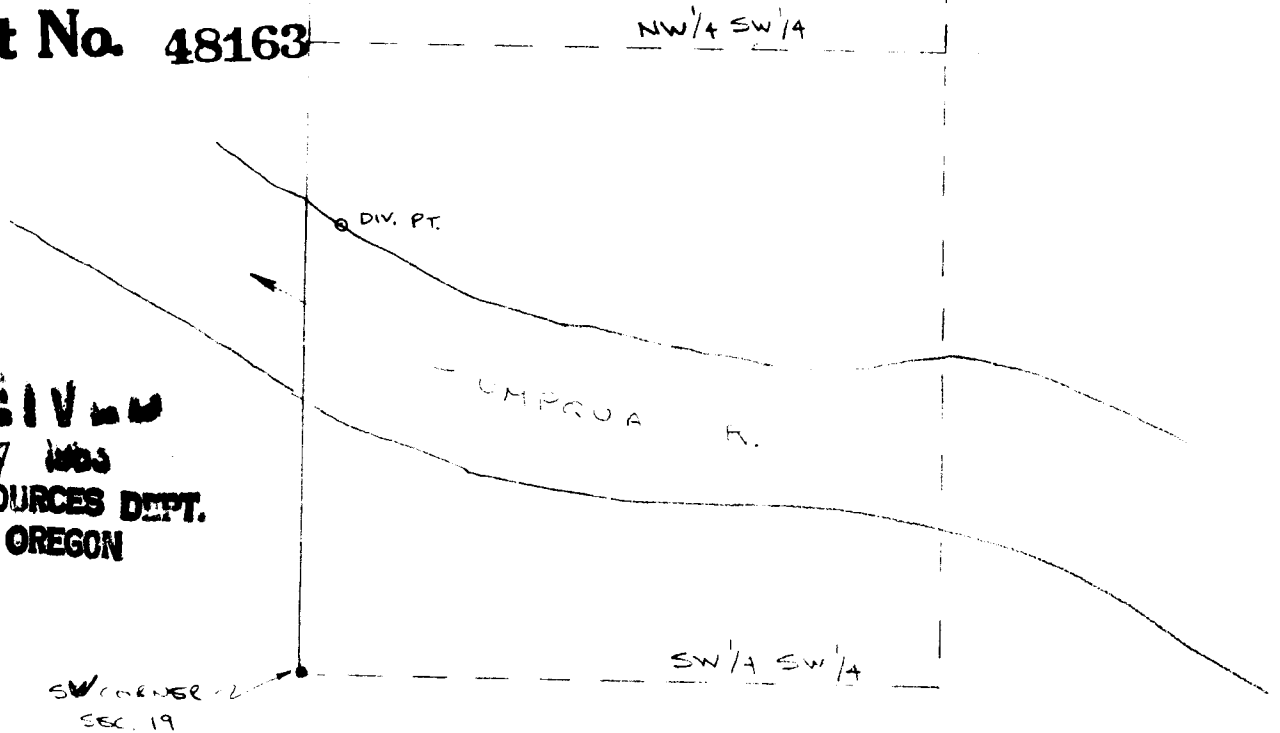

**RECEIVED
DEC 7 1983
WATER RESOURCES DEPT.
SALEM, OREGON**

DIV. PT. = 940 N. & 75 E. FROM SE COR S. 19
(DIV. PT. # 1 of RECORD PERMIT # 17860)

1" = 400'